

CORRECTION(S) TO WATER WELL RECORD (WWC-5)

(to rectify lacking or incorrect information)

County: Neosho

Location listed as:

Location changed to:

Section-Township-Range: 16 - 26S - 17E16 - 27S - 18EFraction ($\frac{1}{4}$ $\frac{1}{4}$ $\frac{1}{4}$): NW SW SWNW SW SW

Other changes: Initial statements: _____

Changed to: _____


Comments: _____

verification method: Online mapping service, Neosho County map, and address
given by drillerinitials: JB date: 10-19-04submitted by: Kansas Geological Survey, Data Resources Library, 1930 Constant Ave., Lawrence, KS 66047-3726
to: Kansas Dept of Health & Environment, Bureau of Water, 1000 SW Jackson, Suite 420, Topeka, KS 66612-1367.

1	LOCATION OF WATER WELL:	Fraction	Section Number	Township Number	Range Number
	County: <u>NEOSHO</u>	<u>NW 1/4 SW 1/4 SW 1/4</u>	<u>16</u>	<u>26 S</u>	<u>17 E</u>

Distance and direction from nearest town or city street address of well if located within city?
1125 N. SANTA FE CHANUTE, KS

2	WATER WELL OWNER: <u>ATOFINA Petrochemicals, Inc</u>	<u>ATTN: JOHN WELHUNT</u>
	RR #, St. Address, Box #: <u>15710 JFK BLVD</u>	Board of Agriculture, Division of Water Resources
	City, State, ZIP Code: <u>HOUSTON, TX 77267-4411</u>	Application Number:

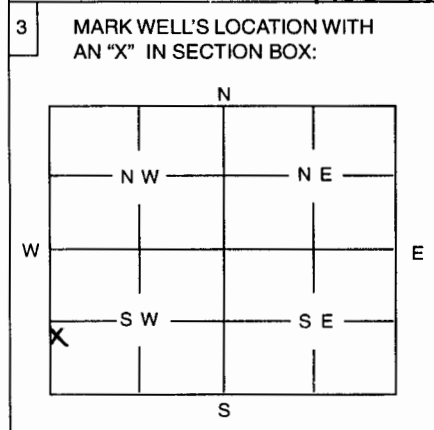

4 DEPTH OF WELL 15 ft

WELL'S STATIC WATER LEVEL 1.42 ft.

WELL WAS USED AS:

1 Domestic	5 Public Water Supply	9 Dewatering
2 Irrigation	6 Oil Field Water Supply	<u>10</u> Monitoring Well
3 Feedlot	7 Domestic (Lawn & Garden)	11 Injection Well
4 Industrial	8 Air Conditioning	12 Other

Was a chemical / bacteriological sample submitted to Department? Yes No

If yes, mo/day/yr sample was submitted

Water Well Disinfected: Yes No

5 TYPE OF BLANK CASING USED:

1 Steel	3 RMP (SR)	5 Wrought	7 Fiberglass	9 Other (Specify below)
<u>2</u> PVC	4 ABS	6 Asbestos-Cement	8 Concrete Tile	

Blank casing diameter 2 in. Was casing pulled? Yes X No If yes, how much 15'

Casing height above or below land surface 0 in.

6 GROUT PLUG MATERIAL: 1 Neat cement 2 Cement grout 3 Bentonite 4 Other

Grout Plug Intervals: From 15 ft. to 3 ft., From ft. to ft., From to ft.

What is the nearest source of possible contamination:

1 Septic tank	6 Seepage pit	11 Fuel storage	16 Other (specify below)
2 Sewer lines	7 Pit privy	12 Fertilizer storage	
3 Watertight sewer lines	8 Sewage lagoon	13 Insecticide storage	
4 Lateral lines	9 Feedyard	14 Abandoned water well	
5 Cess Pool	10 Livestock pens	15 Oil well/Gas well	

Direction from well? How many feet?

FROM	TO	PLUGGING MATERIALS

RECEIVED
 SEP 22 2004
 BUREAU OF WATER

7 CONTRACTOR'S OR LANDOWNER'S CERTIFICATION: This water well was plugged under my jurisdiction and was completed on (mo/day/year) 8-11-04 and this record is true to the best of my knowledge and belief. Kansas Water Well Contractor's License No. 529 This Water Well Record was completed on (mo/day/year) 8/26/2004 under the business name of GEOTECHNOLOGY, INC. by (signature) [Signature]

INSTRUCTIONS: Use typewriter or ball point pen. Please press firmly and print clearly. Please fill in blanks, underline or circle the correct answers. Send top three copies to Kansas Department of Health and Environment, Bureau of Water, Topeka, Kansas 66620-0001. Telephone: 785/296-3565. Send one to Water Well Owner and retain one for your records.