

WATER WELL RECORD Form WWC-5


Original Record Correction Change in Well Use

Division of Water Resources App. No.

Well ID MW-9

1 LOCATION OF WATER WELL: County: <u>Allen</u>	Fraction NW ¼ NW ¼ NE ¼ NE ¼	Section Number <u>4</u>	Township Number <u>T 26 S</u>	Range Number <u>R 18 E W</u>
--	---------------------------------	----------------------------	----------------------------------	---------------------------------

2 WELL OWNER: Last Name: <u>Greenfield Environmental Multistate Trust LLC</u> Business: <u>Greenfield Environmental Multistate Trust LLC</u> Address: <u>1400 Village Square Boulevard, Suite 3-144</u> Address: City: <u>Tallahassee</u> State: <u>FL</u> ZIP: <u>32312</u>	Street or Rural Address where well is located (if unknown, distance and direction from nearest town or intersection): If at owner's address, check here: <input type="checkbox"/> <u>Former Kerr-McGee #6311</u> <u>617 S. 9th Street, Humboldt, KS 66748</u>
---	---

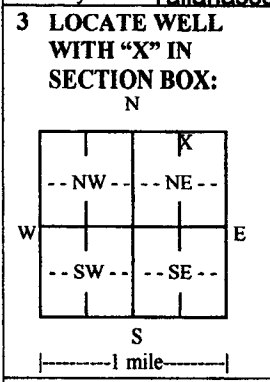

4 DEPTH OF COMPLETED WELL: 50.0 ft.

Depth(s) Groundwater Encountered: 1) Dry ft.
 2) N/A ft. 3) N/A ft., or 4) Dry Well

WELL'S STATIC WATER LEVEL: Dry ft.
 below land surface, measured on (mo-day-yr) 8/6/2020.
 above land surface, measured on (mo-day-yr).....

Pump test data: Well water was N/A ft. after N/A hours pumping N/A gpm
 Well water was N/A ft. after N/A hours pumping N/A gpm

Estimated Yield: N/A gpm
 Bore Hole Diameter: 6.0 in. to 50.0 ft. and N/A in. to N/A ft.

5 Latitude: 37.80573 (decimal degrees)
Longitude: 95.43562 (decimal degrees)
 Horizontal Datum: WGS 84 NAD 83 NAD 27
 Source for Latitude/Longitude:
 GPS (unit make/model:)
 (WAAS enabled? Yes No)
 Land Survey Topographic Map
 Online Mapper:

6 Elevation: 968.46 ft. Ground Level TOC
 Source: Land Survey GPS Topographic Map
 Other

7 WELL WATER TO BE USED AS:

1. Domestic: <input type="checkbox"/> Household <input type="checkbox"/> Lawn & Garden <input type="checkbox"/> Livestock 2. <input type="checkbox"/> Irrigation 3. <input type="checkbox"/> Feedlot 4. <input type="checkbox"/> Industrial	5. <input type="checkbox"/> Public Water Supply: well ID	10. <input type="checkbox"/> Oil Field Water Supply: lease
6. <input type="checkbox"/> Dewatering: how many wells?	7. <input type="checkbox"/> Aquifer Recharge: well ID	11. Test Hole: well ID
8. <input checked="" type="checkbox"/> Monitoring: well ID <u>MW-9</u>	9. Environmental Remediation: well ID	<input type="checkbox"/> Cased <input type="checkbox"/> Uncased <input type="checkbox"/> Geotechnical
<input type="checkbox"/> Air Sparge <input type="checkbox"/> Soil Vapor Extraction <input type="checkbox"/> Recovery <input type="checkbox"/> Injection	12. Geothermal: how many bores?	a) Closed Loop <input type="checkbox"/> Horizontal <input type="checkbox"/> Vertical b) Open Loop <input type="checkbox"/> Surface Discharge <input type="checkbox"/> Inj. of Water
		13. <input type="checkbox"/> Other (specify):

Was a chemical/bacteriological sample submitted to KDHE? Yes No If yes, date sample was submitted:

Water well disinfected? Yes No

8 TYPE OF CASING USED: Steel PVC Other

Casing diameter 2 in. to 50.0 ft., Diameter N/A in. to N/A ft., Diameter N/A in. to N/A ft.
 Casing height above land surface 0 in. Weight N/A lbs/ft. Wall thickness or gauge No. Sch. 40

CASING JOINTS: Glued Clamped Welded Threaded

TYPE OF SCREEN OR PERFORATION MATERIAL:
 Steel Stainless Steel Fiberglass PVC Other (Specify)

Brass Galvanized Steel Concrete tile None used (open hole)

SCREEN OR PERFORATION OPENINGS ARE:
 Continuous Slot Mill Slot Gauze Wrapped Torch Cut Drilled Holes Other (Specify)

Louvered Shutter Key Punched Wire Wrapped Saw Cut None (Open Hole)

SCREEN-PERFORATED INTERVALS: From 30.0 ft. to 50.0 ft. From N/A ft. to N/A ft. From N/A ft. to N/A ft.

GRAVEL PACK INTERVALS: From 28.0 ft. to 50.0 ft. From N/A ft. to N/A ft. From N/A ft. to N/A ft.

9 GROUT MATERIAL: Neat cement Cement grout Bentonite Other Concrete 0 to 2

Grout Intervals: From 2 ft. to 28.0 ft., From N/A ft. to N/A ft., From N/A ft. to N/A ft.

Nearest source of possible contamination:

<input type="checkbox"/> Septic Tank	<input type="checkbox"/> Lateral Lines	<input type="checkbox"/> Pit Privy	<input type="checkbox"/> Livestock Pens	<input type="checkbox"/> Insecticide Storage
<input type="checkbox"/> Sewer Lines	<input type="checkbox"/> Cess Pool	<input type="checkbox"/> Sewage Lagoon	<input checked="" type="checkbox"/> Fuel Storage	<input type="checkbox"/> Abandoned Water Well
<input type="checkbox"/> Watertight Sewer Lines	<input type="checkbox"/> Seepage Pit	<input type="checkbox"/> Feedyard	<input type="checkbox"/> Fertilizer Storage	<input type="checkbox"/> Oil Well/Gas Well
<input type="checkbox"/> Other (Specify)				

Direction from well? NE Distance from well? 150 ft.

10 FROM	TO	LITHOLOGIC LOG	FROM	TO	LITHO. LOG (cont.) or PLUGGING INTERVALS
0	0.5	Grass/topsoil			
0.5	5	No recovery, air knife - clay			
5	7.5	Light brown clay			
7.5	42	Tan weathered limestone			
42	50	Dark gray weathered shale			
50	-	Light tan weathered limestone			
Notes: This WWC-5 was updated on 3/5/2021.					

11 CONTRACTOR'S OR LANDOWNER'S CERTIFICATION: This water well was constructed, reconstructed, or plugged under my jurisdiction and was completed on (mo-day-year) 9/28/20 and this record is true to the best of my knowledge and belief. Kansas Water Well Contractor's License No. 759 This Water Well Record was completed on (mo-day-year) 10/24/2020 under the business name of RAZEK Environmental LLC Signature [Signature]

Kerr-McGee #6311 Property Boundary	Commercial	Overhead Electric	Former Garage Bay
Geotechnical Boring	Exempt	Gas	Former Product Lines
Monitoring Well	Residential	Unidentified	Former Pump Island
Soil Boring	Vacant	Water	Former Station Building
			Former UST

Notes:
 1) Groundwater flow direction unknown, but inferred towards the west-southwest based on topography and regional drainage
 2) All known utilities visible during the site visit are shown. Underground utilities found during GPR Survey are shown.



DESIGNED BY:	CP
DRAWN BY:	CP
CHECKED BY:	JM
APPROVED BY:	CC
DATE:	MAY 2020



Site Map
Kerr-McGee #6311 - Humboldt

Prepared for

 Greenfield Environmental Multistate Trust LLC
 Trustee of the Multistate Environmental Response Trust

617 S. 9th Street
 Humboldt, Kansas
 U3-001-15159

Figure
2

**Limited Site Assessment
 Work Plan**