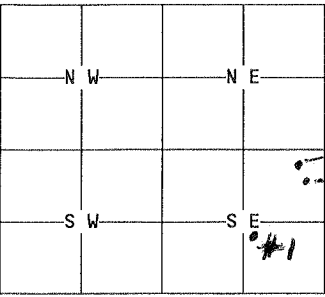


1	LOCATION OF WATER WELL:	Fraction 3/4 1/4 1/4 SE 1/4	Section Number 26	Township Number 26	Range Number 19E	
Distance and direction from nearest town or city street address of well if located within city? 10 miles east of Petrolia or 8 miles west of Saronburg, KS	
2	WATER WELL OWNER: Estel Cottle RR#, St. Address, Box #: Route 1, Box 2 City, State, ZIP Code: Saronburg, KS 66772	
Board of Agriculture, Division of Water Resources Application Number:	
3	MARK WELL'S LOCATION WITH AN "X" IN SECTION BOX: N  S		4 DEPTH OF WELL #1 20, #2 30, #3 60 ft. WELL'S STATIC WATER LEVEL #1 5 ft. WELL WAS USED AS: <table style="width:100%;"> <tr> <td>① Domestic</td> <td>5 Public Water Supply</td> <td>9 Dewatering</td> </tr> <tr> <td>2 Irrigation</td> <td>6 Oil Field Water Supply</td> <td>10 Monitoring Well</td> </tr> <tr> <td>3 Feedlot</td> <td>7 Lawn and Garden Only</td> <td>11 Injection Well</td> </tr> <tr> <td>4 Industrial</td> <td>8 Air Conditioning</td> <td>12 Other.....</td> </tr> </table> Was a chemical/bacteriological sample submitted to Department? Yes....No... If yes, mo/day/yr sample was submitted..... Water Well Disinfected: Yes...K... No.....			① Domestic	5 Public Water Supply	9 Dewatering	2 Irrigation	6 Oil Field Water Supply	10 Monitoring Well	3 Feedlot	7 Lawn and Garden Only	11 Injection Well	4 Industrial	8 Air Conditioning	12 Other.....	
5	TYPE OF BLANK CASING USED: 1 Steel 3 RMP (SR) 5 Wrought 7 Fiberglass 9 Other (specify below) 2 PVC 4 ABS 6 Asbestos-Cement 8 Concrete Tile #1 1 1/2" Rucka Blank casing diameter #3 8 1/4 in. Was casing pulled? Yes..... No... Casing height above or below land surface below in.	
6	GROUT PLUG MATERIAL: 1 Neat cement 2 Cement grout 3 Bentonite 4 Other..... Grout Plug Intervals: From.....ft. to.....ft., From.....ft. to.....ft., From..... to.....ft. What is the nearest source of possible contamination: <table style="width:100%;"> <tr> <td>1 Septic tank</td> <td>6 Seepage pit</td> <td>11 Fuel storage</td> <td>16 Other (specify below)</td> </tr> <tr> <td>2 Sewer lines</td> <td>7 Pit privy</td> <td>12 Fertilizer storage</td> <td></td> </tr> <tr> <td>3 Watertight sewer lines</td> <td>8 Sewage lagoon</td> <td>13 Insecticide storage</td> <td></td> </tr> <tr> <td>4 Lateral lines</td> <td>9 Feedyard</td> <td>14 Abandoned water well</td> <td></td> </tr> <tr> <td>5 Cess Pool</td> <td>10 Livestock pens</td> <td>15 Oil well/Gas well</td> <td></td> </tr> </table> Direction from well? South How many feet? #2 #3 <table border="1" style="width:100%; border-collapse: collapse;"> <thead> <tr> <th>FROM</th> <th>TO</th> <th>#1 PLUGGING MATERIALS</th> <th>#2</th> <th>#3</th> </tr> </thead> <tbody> <tr> <td>20</td> <td>15</td> <td>Gravel</td> <td>30-20 Gravel</td> <td>60-56 sand</td> </tr> <tr> <td>15</td> <td>5</td> <td>Subsoil</td> <td>20-5 Subsoil</td> <td>56-6 subsoil</td> </tr> <tr> <td>5</td> <td>4.5</td> <td>Bentonite</td> <td>5-4.5 Bentonite</td> <td>6-.3 Bentonite</td> </tr> <tr> <td>4.5</td> <td>Surface</td> <td>Topsoil</td> <td>4.5-Surface Topsoil</td> <td>3-Surface Topsoil</td> </tr> <tr><td> </td><td> </td><td> </td><td> </td><td> </td></tr> <tr><td> </td><td> </td><td> </td><td> </td><td> </td></tr> <tr><td> </td><td> </td><td> </td><td> </td><td> </td></tr>
7	CONTRACTOR'S OR LANDOWNER'S CERTIFICATION: This water well was plugged under my jurisdiction and was completed on (mo/day/year) 10/10/95 and this record is true to the best of my knowledge and belief. Kansas Water Well Contractor's License No. 10-19-95 This Water Well Record was completed on (mo/day/year) 10-19-95 under the business name of Estel Cottle by (signature) Estel Cottle	

INSTRUCTIONS: Use typewriter or ball point pen. Please press firmly and print clearly. Please fill in blanks, underline or circle the correct answers. Send top three copies to Kansas Department of Health and Environment, Bureau of Water, Topeka, Kansas 66620-0001. Telephone: 913/296-3565. Send one to Water Well Owner and retain one for your records.