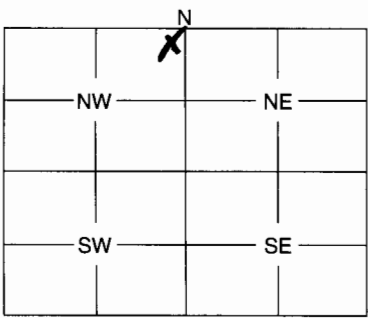


1	LOCATION OF WATER WELL:	Fraction	Section Number	Township Number	Range Number																								
	County: SEDGWICK	NE 1/4 NE 1/4 NW 1/4	25	26S	2E 0																								
Distance and direction from nearest town or city street address of well if located within city? 30 ft west of 14915 E. 45th St. N. Wichita KS 67228																													
2	WATER WELL OWNER: Ray Burdick RR #, St. Address, Box #: P.O. Box 780806 City, State, ZIP Code: Wichita KS 67228																												
			Board of Agriculture, Division of Water Resources Application Number: Unknown																										
3	MARK WELL'S LOCATION WITH AN "X" IN SECTION BOX: <div style="text-align: center;">  </div>		4	DEPTH OF WELL 45 ft. WELL'S STATIC WATER LEVEL 20 ft. WELL WAS USED AS: <div style="display: flex; justify-content: space-between;"> <div> 1 Domestic 2 Irrigation 3 Feedlot 4 Industrial </div> <div> 5 Public Water Supply 6 Oil Field Water Supply 7 Domestic (Lawn & Garden) 8 Air Conditioning </div> <div> 9 Dewatering 10 Monitoring Well 11 Injection Well 12 Other </div> </div>																									
Was a chemical / bacteriological sample submitted to Department? Yes No X If yes, mo/day/yr sample was submitted Water Well Disinfected: Yes X No																													
5	TYPE OF BLANK CASING USED: <div style="display: flex; justify-content: space-between;"> <div> 1 Steel 2 PVC </div> <div> 3 RMP (SR) 4 ABS </div> <div> 5 Wrought 6 Asbestos-Cement </div> <div> 7 Fiberglass 8 Concrete Tile </div> <div> 9 Other (Specify below) </div> </div>																												
Blank casing diameter in. Was casing pulled? Yes X No If yes, how much 3 ft Casing height above or below land surface 3 ft in.																													
6	GROUT PLUG MATERIAL: 1 Neat cement 2 Cement grout 3 Bentonite 4 Other Grout Plug Intervals: From 20 ft. to 3 ft., From ft. to ft., From ft. to ft. What is the nearest source of possible contamination: <div style="display: flex; justify-content: space-between;"> <div> 1 Septic tank 2 Sewer lines 3 Watertight sewer lines 4 Lateral lines 5 Cess pool </div> <div> 6 Seepage pit 7 Pit privy 8 Sewage lagoon 9 Feedyard 10 Livestock pens </div> <div> 11 Fuel storage 12 Fertilizer storage 13 Insecticide storage 14 Abandoned water well 15 Oil well/Gas well </div> <div> 16 Other (specify below) Well was abandoned </div> </div>																												
Direction from well? How many feet?																													
<table border="1" style="width:100%; border-collapse: collapse;"> <thead> <tr> <th style="width:10%;">FROM</th> <th style="width:10%;">TO</th> <th style="width:80%;">PLUGGING MATERIALS</th> </tr> </thead> <tbody> <tr> <td>3</td> <td>0</td> <td>Topsoil</td> </tr> <tr> <td>20</td> <td>3</td> <td>Bentonite</td> </tr> <tr> <td>45</td> <td>20</td> <td>Sand / bleach</td> </tr> <tr><td> </td><td> </td><td> </td></tr> <tr><td> </td><td> </td><td> </td></tr> <tr><td> </td><td> </td><td> </td></tr> <tr><td> </td><td> </td><td> </td></tr> </tbody> </table>						FROM	TO	PLUGGING MATERIALS	3	0	Topsoil	20	3	Bentonite	45	20	Sand / bleach												
FROM	TO	PLUGGING MATERIALS																											
3	0	Topsoil																											
20	3	Bentonite																											
45	20	Sand / bleach																											
7	CONTRACTOR'S OR LANDOWNER'S CERTIFICATION: This water well was plugged under my jurisdiction and was completed on (mo/day/year) 8/20/05 and this record is true to the best of my knowledge and belief. Kansas Water Well Contractor's License No. 628 This Water Well Record was completed on (mo/day/year) 8/20/05 under the business name of JWL Enterprises by (signature) Jamie M. Ryse																												
INSTRUCTIONS: Use typewriter or ball point pen. Please press firmly and print clearly. Please fill in blanks, underline or circle the correct answers. Send top three copies to Kansas Department of Health and Environment, Bureau of Water, Geology Section, 1000 SW Jackson St., Ste. 420, Topeka, Kansas 66612-1367. Telephone: 785/296-5522. Send one to Water Well Owner and retain one for your records.																													