

MW-2

**WATER WELL PLUGGING RECORD Form WWC-5P**

KSA 82a-1212


ID NO.

<b>1 LOCATION OF WATER WELL:</b> County: Sedgwick	Fraction ¼ NE ¼ NE ¼ NE ¼	Section Number 8	Township Number T 26 S	Range Number 2 <input checked="" type="checkbox"/> E <input type="checkbox"/> W
--	------------------------------	---------------------	---------------------------	--

Street/Rural Address of Well Location; if unknown, distance & direction from nearest town or intersection: If at owner's address, check here  125 ft. north of intersection of 69th st and Webb road on on east side of Webb

**2 WATER WELL OWNER:** Magellan / Chase Pipeline  
RR#, St. Address, Box #: 69th & Webb Road  
City, State ZIP Code: Wichita, Kansas

**Global Positioning Systems (GPS) information:**  
Latitude: 38deg59'50" (in decimal degrees)  
Longitude: 00deg47'57" (in decimal degrees)  
Elevation: \_\_\_\_\_  
Datum:  WGS84,  NAD83,  NAD27  
Collection Method:  
 GPS unit (Make/Model: \_\_\_\_\_)  
 Digital Map/Photo,  Topographic Map,  Land Survey  
Est. Accuracy:  < 3 m,  3-5 m,  5-15 m,  > 15 m

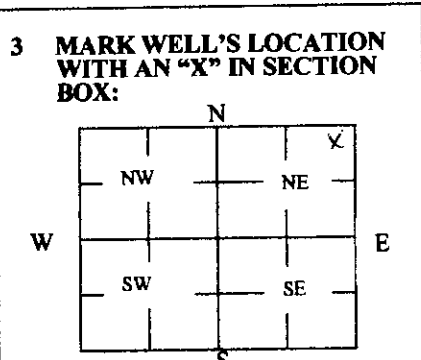

**4 DEPTH OF WELL** 12.1 ft.  
**WELL'S STATIC WATER LEVEL** 7.5 ft.  
**WELL WAS USED AS:**  
 Domestic  
 Irrigation  
 Feedlot  
 Industrial  
 Public Water Supply  
 Oil Field Water Supply  
 Domestic (Lawn & Garden)  
 Air Conditioning  
 Dewatering  
 Monitoring  
 Injection Well  
 Other \_\_\_\_\_  
 Was a chemical/bacteriological sample submitted to Department? Yes  No

**5 TYPE OF BLANK CASING USED:**  
 Steel  
 PVC  
 RMP (SR)  
 ABS  
 Wrought  
 Asbestos-Cement  
 Fiberglass  
 Concrete Tile  
 Other (Specify below) \_\_\_\_\_  
 Blank casing diameter 2 in. Was casing pulled? Yes  No  If yes, how much all  
 Casing height above or below land surface 0 in.

**6 GROUT PLUG MATERIAL:**  Neat cement  Cement grout  Bentonite  Other \_\_\_\_\_  
 Grout Plug Intervals: From 0 ft. to 13.1 ft., From \_\_\_\_\_ ft. to \_\_\_\_\_ ft., From \_\_\_\_\_ to \_\_\_\_\_ ft.  
 What is the nearest source of possible contamination:  
 Septic tank  
 Sewer lines  
 Watertight sewer lines  
 Lateral lines  
 Cess pool  
 Seepage pit  
 Pit privy  
 Sewage lagoon  
 Feedyard  
 Livestock pens  
 Fuel Storage  
 Fertilizer storage  
 Insecticide storage  
 Abandoned water well  
 Oil well/Gas well  
 Other (specify below) \_\_\_\_\_  
 Direction from well? \_\_\_\_\_  
 How many feet? \_\_\_\_\_

FROM	TO	PLUGGING MATERIALS	FROM	TO	PLUGGING MATERIALS
0	13.1	Bentonite			

**7 CONTRACTOR'S OR LANDOWNER'S CERTIFICATION:** This water well was plugged under my jurisdiction and was completed on (mo/day/year) 11/26/19 and this record is true to the best of my knowledge and belief. Kansas Water Well Contractor's License No. 604. This Water Well Record was completed on (mo/day/year) 12/1/19 under the business name of Environmental Priority Service, Inc. by (signature) [Signature]

**INSTRUCTIONS:** Use typewriter or ballpoint pen. Please press firmly and print clearly. Please fill in blanks, underline or circle the correct answers. Send one copy to Kansas Department of Health and Environment, Bureau of Water, Geology Section, 1000 SW Jackson St., Ste. 420, Topeka, Kansas 66612-1367. Telephone: 785/296-5524. Send one to Water Well Owner and retain one for your records. Visit us at <http://www.kdheks.gov/waterwell/index.html>.