

WATER WELL RECORD Form WWC-5


Original Record Correction Change in Well Use

Division of Water Resources App. No. []

Well ID []

1 LOCATION OF WATER WELL:
County: **SEDGWICK** Fraction NE 1/4 SE 1/4 SE 1/4 SW 1/4 Section Number **26** Township Number **T 26 S** Range Number **R 2 E**

2 WELL OWNER: Last Name: **HEGEMEIST** First: **SHERRY** Street or Rural Address where well is located (if unknown, distance and direction from nearest town or intersection): If at owner's address, check here:
Business: Address: **13600 EAST 37TH STREET NORTH** WELL #1
Address: City: **WICHITA** State: **KS** ZIP: **67230**

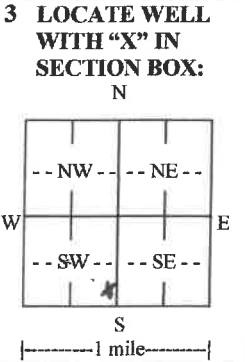

4 DEPTH OF COMPLETED WELL:75..... ft.
Depth(s) Groundwater Encountered: 1)42..... ft.
2) ft. 3) ft., or 4) Dry Well
WELL'S STATIC WATER LEVEL:30..... ft.
 below land surface, measured on (mo-day-yr)9/9/2019.....
 above land surface, measured on (mo-day-yr).....
Pump test data: Well water was ft.
after..... hours pumping gpm
Well water was ft.
after..... hours pumping gpm
Estimated Yield:20..... gpm
Bore Hole Diameter:11.5..... in. to75..... ft. and
..... in. to ft.

5 Latitude:(decimal degrees)
Longitude:(decimal degrees)
Horizontal Datum: WGS 84 NAD 83 NAD 27
Source for Latitude/Longitude:
 GPS (unit make/model:)
(WAAS enabled? Yes No)
 Land Survey Topographic Map
 Online Mapper:

6 Elevation:ft. Ground Level TOC
Source: Land Survey GPS Topographic Map
 Other

7 WELL WATER TO BE USED AS:
1. Domestic: Household Lawn & Garden Livestock
2. Irrigation
3. Feedlot
4. Industrial
5. Public Water Supply: well ID
6. Dewatering: how many wells?
7. Aquifer Recharge: well ID
8. Monitoring: well ID
9. Environmental Remediation: well ID
 Air Sparge Soil Vapor Extraction
 Recovery Injection
10. Oil Field Water Supply: lease
11. Test Hole: well ID
 Cased Uncased Geotechnical
12. Geothermal: how many bores?
a) Closed Loop Horizontal Vertical
b) Open Loop Surface Discharge Inj. of Water
13. Other (specify):

Was a chemical/bacteriological sample submitted to KDHE? Yes No If yes, date sample was submitted:
Water well disinfected? Yes No

8 TYPE OF CASING USED: Steel PVC Other CASING JOINTS: Glued Clamped Welded Threaded
Casing diameter5..... in. to75..... ft., Diameter in. to ft., Diameter in. to ft.
Casing height above land surface16..... in. Weight lbs./ft. Wall thickness or gauge No. **SDR-26**.....

TYPE OF SCREEN OR PERFORATION MATERIAL:
 Steel Stainless Steel Fiberglass PVC Other (Specify)
 Brass Galvanized Steel Concrete tile None used (open hole)

SCREEN OR PERFORATION OPENINGS ARE:
 Continuous Mill Slot Gauze Wrapped Torch Cut Drilled Holes Other (Specify)
 Louvered Shutter Key Punched Wire Wrapped Saw Cut None (Open Hole)

SCREEN-PERFORATED INTERVALS: From **.25**..... ft. to **75**..... ft., From ft. to ft., From ft. to ft.
GRAVEL PACK INTERVALS: From **.22**..... ft. to **75**..... ft., From ft. to ft., From ft. to ft.

9 GROUT MATERIAL: Neat cement Cement grout Bentonite Other
Grout Intervals: From **3**..... ft. to **22**..... ft., From ft. to ft., From ft. to ft.

Nearest source of possible contamination:
 Septic Tank Lateral Lines Pit Privy Livestock Pens Insecticide Storage
 Sewer Lines Cess Pool Sewage Lagoon Fuel Storage Abandoned Water Well
 Watertight Sewer Lines Seepage Pit Feedyard Fertilizer Storage Oil Well/Gas Well
 Other (Specify) **POND**.....
Direction from well? **NORTH**..... Distance from well? **200 PLUS**..... ft.

10 FROM	TO	LITHOLOGIC LOG	FROM	TO	LITHO. LOG (cont.) or PLUGGING INTERVALS
0	2	TOP SOIL			
2	30	CLAY			
30	41	GRAY SHALE			
41	46	LIMESTONE			
46	75	GRAY SHALE			

Notes:

11 CONTRACTOR'S OR LANDOWNER'S CERTIFICATION: This water well was constructed, reconstructed, or plugged under my jurisdiction and was completed on (mo-day-year) **9/16/2019**..... and this record is true to the best of my knowledge and belief. Kansas Water Well Contractor's License No. **884**..... This Water Well Record was completed on (mo-day-year) **10/30/2019**..... under the business name of **WENINGER DRILLING, LLC**..... Signature *Marsha Kozlowski*