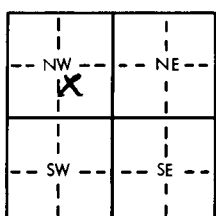
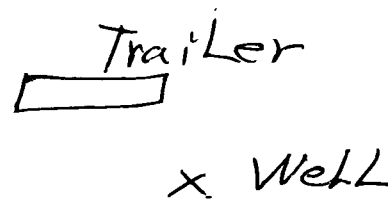


County Sedgwick		Fraction NW 1/4 SE 1/4 NW 1/4	Section number 22	Township number 26 S	Range number 2 R
Location of well: Greenwich City		3. Owner of well: JW Marples R.R. or street: 107 Brownie City, state, zip code: Rose Hill Kan			
4. Locate with "X" in section below: 		Sketch map: 		6. Bore hole dia. 8 in. Completion date 9/25 Well depth 70 ft.	
5. Type and color of material		From	To	7. <input checked="" type="checkbox"/> Cable tool <input type="checkbox"/> Rotary <input type="checkbox"/> Driven <input type="checkbox"/> Dig <input type="checkbox"/> Hollow rod <input type="checkbox"/> Jetted <input type="checkbox"/> Bored <input type="checkbox"/> Reverse rotary	
Soil		0	4	8. Use: <input checked="" type="checkbox"/> Domestic <input type="checkbox"/> Public supply <input type="checkbox"/> Industry <input checked="" type="checkbox"/> Irrigation <input type="checkbox"/> Air conditioning <input type="checkbox"/> Stock <input type="checkbox"/> Lawn <input type="checkbox"/> Oil field water <input type="checkbox"/> Other	
Clay yellow		4	50	9. Casing: Material PS Height: Above or below Threaded <input type="checkbox"/> Welded <input checked="" type="checkbox"/> Surface 18 in. RMP <input type="checkbox"/> PVC <input type="checkbox"/> Weight 100 lbs./ft.	
Shale		50	90	Dia. 6 in. to 90 ft. depth Wall Thickness: inches or Dia. <input type="checkbox"/> in. to <input type="checkbox"/> ft. depth gage No. 1125	
				10. Screen: Manufacturer's name Sun Flower Type 100 Dia. 6 Slot/gauze 1/16 Length 20 Set between 1/16 ft. and 80 ft. Set between <input type="checkbox"/> ft. and <input type="checkbox"/> ft.	
				Gravel pack? <input checked="" type="checkbox"/> Size range of material <input type="checkbox"/>	
				11. Static water level: <input type="checkbox"/> mo./day/yr. 30 ft. below land surface Date 10/1/78	
				12. Pumping level below land surfaces: 30 ft. after 1 hrs. pumping 50 g.p.m. <input type="checkbox"/> ft. after <input type="checkbox"/> hrs. pumping <input type="checkbox"/> g.p.m. Estimated maximum yield 50 g.p.m.	
				13. Water sample submitted: <input type="checkbox"/> mo./day/yr. <input type="checkbox"/> Yes <input checked="" type="checkbox"/> No Date <input type="checkbox"/>	
				14. Well head completion: <input type="checkbox"/> Pitless adapter <input type="checkbox"/> Inches above grade	
				15. Well grouted? Yes With: <input checked="" type="checkbox"/> Neat cement <input type="checkbox"/> Bentonite <input type="checkbox"/> Concrete Depth: From 0 ft. to 10 ft.	
				16. Nearest source of possible contamination: None ft. <input type="checkbox"/> Direction <input type="checkbox"/> Type <input type="checkbox"/> Well disinfected upon completion? <input checked="" type="checkbox"/> Yes <input type="checkbox"/> No	
				17. Pump: <input checked="" type="checkbox"/> Not installed Manufacturer's name <input type="checkbox"/> Model number <input type="checkbox"/> HP <input type="checkbox"/> Volts <input type="checkbox"/> Length of drop pipe <input type="checkbox"/> ft. capacity <input type="checkbox"/> g.p.m. Type: <input type="checkbox"/> Submersible <input type="checkbox"/> Turbine <input type="checkbox"/> Jet <input type="checkbox"/> Reciprocating <input type="checkbox"/> Centrifugal <input type="checkbox"/> Other	
18. Elevation:		19. Remarks:		20. Water well contractor's certification: This well was drilled under my jurisdiction and this report is true to the best of my knowledge and belief. Winterwell Drill 251A Business name 22 Box 30 Augusta Kan License No. <input type="checkbox"/> Address Charles Winters Date 10/6/78 Signature <input type="checkbox"/> Authorized representative	