


1 LOCATION OF WATER WELL: County: Sedgewick Township Number: 20 S Range Number: 2 E  
 Section Number: 30  
 Distance and direction from nearest town or city street address of well if located within city? See Below

2 WATER WELL OWNER: STEVE PRINCE  
 RR#, St. Address, Box #: 3565 N. 159th E.  
 City, State, ZIP Code: Nichita, KS 67228  
 Board of Agriculture, Division of Water Resources  
 Application Number:

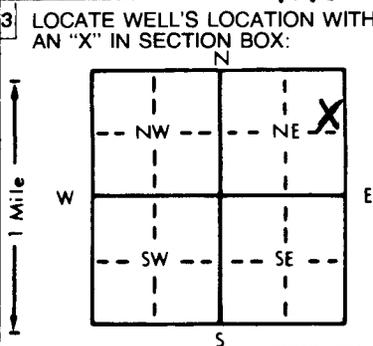

4 DEPTH OF COMPLETED WELL: 80 ft. ELEVATION:  
 Depth(s) Groundwater Encountered: 1 35 ft. 2. 30 ft. 3. 8-24-94 ft.  
 WELL'S STATIC WATER LEVEL: 35 ft. below land surface measured on mo/day/yr 15  
 Pump test data: Well water was 30 ft. after 1/2 hours pumping 15 gpm  
 Est. Yield 15 gpm; Well water was 30 ft. after 15 hours pumping 15 gpm  
 Bore Hole Diameter: 11 in. to 80 ft., and 80 in. to 80 ft.  
 WELL WATER TO BE USED AS:  
 1 Domestic  3 Feedlot  6 Oil field water supply  8 Air conditioning  11 Injection well  
 2 Irrigation  4 Industrial  7 Lawn and garden only  9 Dewatering  12 Other (Specify below)  
 5 Public water supply  10 Monitoring well  
 Was a chemical/bacteriological sample submitted to Department? Yes  No ; If yes, mo/day/yr sample was submitted  
 Water Well Disinfected? Yes  No

5 TYPE OF BLANK CASING USED:  
 1 Steel  3 RMP (SR)  5 Wrought iron  8 Concrete tile  CASING JOINTS: Glued  Clamped   
 2 PVC  4 ABS  6 Asbestos-Cement  9 Other (specify below)  Welded   
 Blank casing diameter 5 in. to 30 ft. Dia 2.60 in. to 100 ft. Dia 100 PSI  
 Casing height above land surface 12 in., weight 2.60 lbs./ft. Wall thickness or gauge No. 100 PSI  
 TYPE OF SCREEN OR PERFORATION MATERIAL:  
 1 Steel  3 Stainless steel  5 Fiberglass  7 PVC  10 Asbestos-cement  
 2 Brass  4 Galvanized steel  6 Concrete tile  8 RMP (SR)  11 Other (specify)  
 12 None used (open hole)  
 SCREEN OR PERFORATION OPENINGS ARE:  
 1 Continuous slot  4 Mill slot  5 Gauzed wrapped  8 Saw cut  11 None (open hole)  
 2 Louvered shutter  4 Key punched  6 Wire wrapped  9 Drilled holes  
 7 Torch cut  10 Other (specify)  
 SCREEN-PERFORATED INTERVALS: From 30 ft. to 80 ft. From 30 ft. to 80 ft.  
 GRAVEL PACK INTERVALS: From 35 ft. to 80 ft. From 35 ft. to 80 ft.

6 GROUT MATERIAL:  1 Neat cement  2 Cement grout  3 Bentonite  4 Other  
 Grout Intervals: From 3 ft. to 35 ft.  
 What is the nearest source of possible contamination:  
 1 Septic tank  4 Lateral lines  7 Pit privy  10 Livestock pens  14 Abandoned water well  
 2 Sewer lines  5 Cess pool  8 Sewage lagoon  11 Fuel storage  15 Oil well/Gas well  
 3 Watertight sewer lines  6 Seepage pit  9 Feedyard  12 Fertilizer storage  16 Other (specify below)  
 13 Insecticide storage  
 Direction from well? West How many feet? 150

| FROM | TO | LITHOLOGIC LOG | FROM | TO | PLUGGING INTERVALS |
|------|----|----------------|------|----|--------------------|
| 0    | 2  | Top Soil       |      |    |                    |
| 2    | 29 | Clay           |      |    |                    |
| 29   | 44 | Shale / lime   |      |    |                    |
| 44   | 76 | Lime stone     |      |    |                    |
| 76   | 81 | Shale / lime   |      |    |                    |

7 CONTRACTOR'S OR LANDOWNER'S CERTIFICATION: This water well was  (1) constructed,  (2) reconstructed, or  (3) plugged under my jurisdiction and was completed on (mo/day/year) 8-24-84 and this record is true to the best of my knowledge and belief. Kansas Water Well Contractor's License No. 318 This Water Well Record was completed on (mo/day/yr) 8-25-94 under the business name of Weninger Drilling by (signature) Karrina Morrison

OFFICE USE ONLY  
T  
R  
EW  
SEC  
1/4  
1/4  
1/4