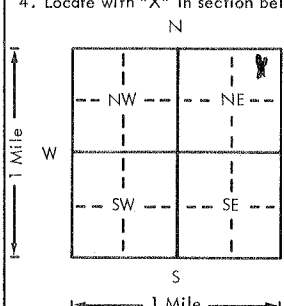
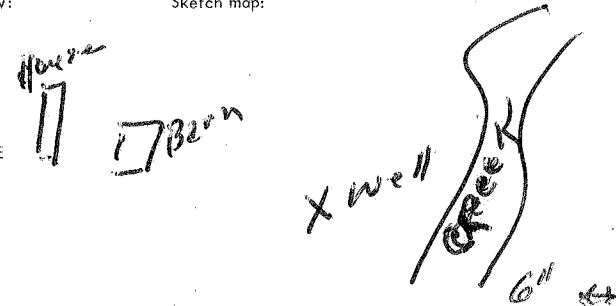


USE TYPEWRITER OR BALL
POINT PEN-PRESS FIRMLY,
PRINT CLEARLY.

WATER WELL RECORD
KSA 82a-1201-1215

Kansas Department of Health and
Environment-Division of Environment
(Water well Contractors)
Topeka, Kansas 66620

1. Location of well:	County: <u>Allen</u>	Fraction: <u>NE 1/4 NE 1/4</u>	Section number: <u>4</u>	Township number: <u>T 26 S R 20 E</u>	Range number: <u>20</u>
2. Distance and direction from nearest town or city: <u>6 miles south & 3 miles west Moran</u>		3. Owner of well: <u>Eugene Parsons</u> R.R. or street: <u>RR 1</u> City, state, zip code: <u>Elsmore, Kans 66732</u>			
4. Locate with "X" in section below: 		Sketch map: 			
5. Type and color of material		From	To	6. Bore hole dia. <u>6"</u> in. Completion date <u>7/25/78</u> Well depth <u>118</u> ft.	
				7. ☒ Cable tool ☐ Rotary ☐ Driven ☐ Dug ☐ Hollow rod ☐ Jetted ☐ Bored ☐ Reverse rotary	
				8. Use: ☐ Domestic ☐ Public supply ☐ Industry ☐ Irrigation ☐ Air conditioning ☒ Stock ☐ Lawn ☐ Oil field water ☐ Other	
				9. Casing: Material <u>PVC</u> Height Above or below Threading <u>Well</u> Surface <u>12</u> in. RMP <u>PVC</u> Weight <u>12</u> lbs./ft. Dia. <u>6</u> in. to <u>118</u> ft. depth Wall Thickness: inches or Dia. <u>6</u> in. to <u>118</u> ft. depth Gauge No. <u>255</u>	
				10. Screen: Manufacturer's name <u>Jetstream</u> Type <u>100</u> Dia. <u>6"</u> Slot/gauze <u>0.30</u> Length <u>118</u> Set between <u>58</u> ft. and <u>118</u> ft. Gravel pack? ☒ Size range of material <u>1/8 to 3/4</u>	
				11. Static water level: <u>91</u> ft. below land surface Date <u>7/25/78</u> mo./day/yr.	
				12. Pumping level below land surfaces: ____ ft. after ____ hrs. pumping ____ g.p.m. ____ ft. after ____ hrs. pumping ____ g.p.m. Estimated maximum yield ____ g.p.m.	
				13. Water sample submitted: ____ mo./day/yr. ____ Yes ____ No Date ____	
				14. Well head completion: ____ Pitless adapter ____ Inches above grade	
				15. Well grouted? <u>Yes</u> With: ☒ Neat cement ☐ Bentonite ☐ Concrete Depth: From <u>0</u> ft. to <u>10</u> ft.	
				16. Nearest source of possible contamination: ft. <u>150</u> Direction <u>West</u> Type <u>Septic</u> Well disinfected upon completion? ☒ Yes ____ No	
				17. Pump: ☒ Not installed Manufacturer's name ____ Model number ____ HP ____ Volts ____ Length of drop pipe ____ ft. capacity ____ g.p.m. Type: ____ Submersible ____ Turbine ____ Jet ____ Reciprocating ____ Centrifugal ____ Other	
18. Elevation:		19. Remarks: (Use a second sheet if needed)			
Topography: ____ Hill ____ Slope ☒ Upland ____ Valley		20. Water well contractor's certification: This well was drilled under my jurisdiction and this report is true to the best of my knowledge and belief. <u>Eurekz Well Service</u> <u>296</u> Business name License No. <u>225 S. Walnut & Eurekz, Kans</u> Address Signed <u>True Ashcraft</u> Date <u>7-25-78</u> Authorized representative			

Forward the white, blue and pink copies to the Department of Health and Environment

Form WWC-5