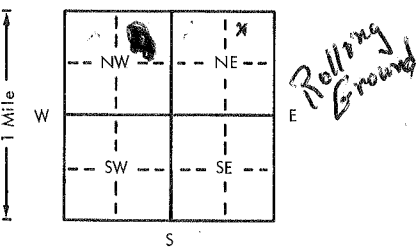


USE TYPEWRITER OR BALL
POINT PEN-PRESS FIRMLY,
PRINT CLEARLY.

WATER WELL RECORD
KSA 82a-1201-1215

Kansas Department of Health and
Environment-Division of Environment
(Water well Contractors)
Topeka, Kansas 66620

County: <u>Allen</u>		Fraction: <u>SE 1/4 NW 1/4 NE 1/4</u>	Section number: <u>4</u>	Township number: <u>T 26</u>	Range number: <u>S R 21</u>	<u>(EW)</u>
2. Distance and direction from nearest town or city: <u>5 miles S - 3 miles East of Moran, Kansas</u>			3. Owner of well: <u>Gary Fewins</u> R.R. or street: <u>RR 1</u> City, state, zip code: <u>Moran, Kansas</u>			
4. Locate with "X" in section below: 			6. Bore hole dia. <u>8 3/4</u> in. Completion date: <u>10/17/77</u> Well depth: <u>40</u> ft.			
5. Type and color of material			7. <input checked="" type="checkbox"/> Cable tool <input type="checkbox"/> Rotary <input type="checkbox"/> Driven <input type="checkbox"/> Dug <input type="checkbox"/> Hollow rod <input type="checkbox"/> Jetted <input type="checkbox"/> Bored <input type="checkbox"/> Reverse rotary			
			8. Use: <input checked="" type="checkbox"/> Domestic <input type="checkbox"/> Public supply <input type="checkbox"/> Industry <input type="checkbox"/> Irrigation <input type="checkbox"/> Air conditioning <input type="checkbox"/> Stock <input type="checkbox"/> Lawn <input type="checkbox"/> Oil field water <input type="checkbox"/> Other			
			9. Casing: Material: <u>Steel</u> Height: <u>Above</u> or <u>below</u> Threaded <input type="checkbox"/> Welded <input type="checkbox"/> Surface <u>12"</u> in. RMP <input type="checkbox"/> PVC <input checked="" type="checkbox"/> Weight <u> </u> lbs./ft. Dia. <u>6</u> in. to <u>20</u> ft. depth Wall Thickness: inches or Dia. <u> </u> in. to <u> </u> ft. depth Gauge No. <u>255</u>			
			10. Screen: Manufacturer's name <u> </u> Type <u>NO A/E</u> Slot/gauze <u> </u> Length <u> </u> Set between <u> </u> ft. and <u> </u> ft. <u> </u> ft. and <u> </u> ft. Gravel pack? <input type="checkbox"/> Size range of material <u> </u>			
			11. Static water level: <u> </u> mo./day/yr. <u>8</u> ft. below land surface Date <u>10/17/77</u>			
			12. Pumping level below land surfaces: <u> </u> ft. after <u> </u> hrs. pumping <u> </u> g.p.m. <u> </u> ft. after <u> </u> hrs. pumping <u> </u> g.p.m. Estimated maximum yield <u> </u> g.p.m.			
			13. Water sample submitted: <u> </u> mo./day/yr. <input type="checkbox"/> Yes <input type="checkbox"/> No Date <u> </u>			
			14. Well head completion: <input type="checkbox"/> Pitless adapter <u> </u> Inches above grade			
			15. Well grouted? <input checked="" type="checkbox"/> With: <input checked="" type="checkbox"/> Neat cement <input type="checkbox"/> Bentonite <input type="checkbox"/> Concrete Depth: From <u>0</u> ft. to <u>10</u> ft.			
			16. Nearest source of possible contamination: ft. <u>100</u> Direction <u>SW</u> Type <u>Septic</u> Well disinfected upon completion? <input checked="" type="checkbox"/> Yes <input type="checkbox"/> No			
			17. Pump: <input checked="" type="checkbox"/> Not installed Manufacturer's name <u> </u> Model number <u> </u> HP <u> </u> Volts <u> </u> Length of drop pipe <u> </u> ft. capacity <u> </u> g.p.m. Type: <input type="checkbox"/> Submersible <input type="checkbox"/> Turbine <input type="checkbox"/> Jet <input type="checkbox"/> Reciprocating <input type="checkbox"/> Centrifugal <input type="checkbox"/> Other			
			18. Elevation: <u> </u>			
			19. Remarks: (Use a second sheet if needed)			
			20. Water well contractor's certification: This well was drilled under my jurisdiction and this report is true to the best of my knowledge and belief. <u>Eureka Well Service 296</u> Business name License No. <u> </u> Address <u>Eureka, Kansas</u> Signed <u>True Ashlock</u> Date <u>10/17/77</u> Authorized representative			
			21. Topography: <input type="checkbox"/> Hill <input checked="" type="checkbox"/> Slope <input type="checkbox"/> Upland <input type="checkbox"/> Valley			

Forward the white, blue and pink copies to the Department of Health and Environment

Form WWC-5