


WATER WELL RECORD Form WWC-5 KSA 82a-1212

DRL  
9/14/09

LOCATION OF WATER WELL: Fraction Section Number Township Number Range Number  
 COUNTY: FORD NE 1/4 NE 1/4 NW 1/4 19 T 26 S R 22 **X W**

Distance and direction from nearest town or city street address of well if located within city?  
 FROM WRIGHT, KS. - 7 MILES EAST ON JEWELL RD.

WATER WELL OWNER: CLAUSSEN, BILL  
 PR#. Sc. Address. Box #: 12399 JEWELL RD. Board of Agriculture, Division of Water Resources  
 City, State, ZIP code: SPEARVILLE, KS 67876- Application Number:

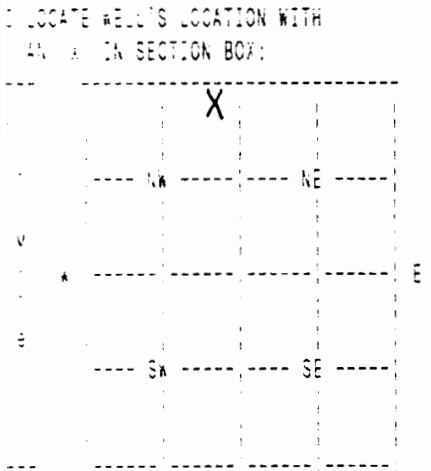

4 DEPTH OF COMPLETED WELL 365 ELEVATION: 0  
 Depth(s) Groundwater Encountered 1. 0 ft. 2. 0 ft. 3. 0 ft.  
 WELL'S STATIC WATER LEVEL 92 ft. below land surface measured on mo/day/yr 01/08/09  
 Pump test data: Well water was 0 ft. after 0 hours pumping 0 gpm  
 Estimated Yield 40 gpm: Well water was 0 ft. after 0 hours pumping 0 gpm  
 Bore Hole Diameter 10 in. to 365 ft., and in. to 0 ft.  
 WELL WATER TO BE USED AS: DOMESTIC  
 Was a chemical/bacteriological sample submitted to department? No ;  
 If yes, mo/day/yr sample was submitted Water well disinfected? Yes

TYPE OF BLANK CASING USED: CERTA LOC CASIN CASING JOINTS: CERTA-LOC  
 Blank casing diameter 5 in. to 365 ft., Dia in. to 0 ft., Dia in. to 0 ft.  
 Casing height above land surface 12 in., weight 200 lbs/ft. Wall thickness or gauge No. 17  
 TYPE OF SCREEN OR PERFORATION MATERIAL: PVC  
 SCREEN OR PERFORATION OPENINGS ARE: SAW CUT

SCREEN PERFORATED INTERVALS: From 120 ft. to 140 ft., From 0 ft. to 0 ft.  
 From 280 ft. to 360 ft., From 0 ft. to 0 ft.  
 GRAVEL PACK INTERVALS: From 25 ft. to 70 ft., From 0 ft. to 0 ft.  
 From 80 ft. to 365 ft., From 0 ft. to 0 ft.

GROUT MATERIAL BENTONITE  
 Grout Intervals: From 5 ft. to 25 ft., From 70 ft. to 80 ft., From 0 ft. to 0 ft.  
 What is the nearest source of possible contamination: NONE  
 Direction from well? How many feet? 0

FROM	TO	LITHOLOGIC LOG	FROM	TO	PLUGGING INTERVALS
0	20	01 TOPSOIL 32 TAN CLAY			
20	48	32 TAN CLAY 10 FINE-MEDSAND			
48	60	32 TAN CLAY 25 YELLOW CLAY			
60	120	16 GRAY CLAY			
120	140	16 GRAY CLAY 29 SANDSTONE			
140	260	16 GRAY CLAY 26 RED CLAY			
260	280	16 GRAY CLAY 29 SANDSTONE			
280	360	29 SANDSTONE			
360	380	29 SANDSTONE 16 GRAY CLAY			
380	420	36 BLUE CLAY			

CONTRACTOR'S OR LANDOWNER'S CERTIFICATION: This water well was Constructed under my jurisdiction and was completed on (mo/day/year) 02/23/09 and this record is true to the best of my knowledge and belief. Kansas Water Well Contractor's License No. 179 This Water Well Record was completed on (mo/day/yr) 03/03/09  
 Under the business name of JOE'S WELL SERVICE, INC. by (signature) *Judith Creek*