

WATER WELL PLUGGING RECORD Form WWC-5P
KSA 82a-1212
ID NO.

1 LOCATION OF WATER WELL: County: Bourbon	Fraction NW ¼ NW¼ NW ¼ SW ¼	Section Number 32	Township Number 26 T S	Range Number 25 <input checked="" type="checkbox"/> E <input type="checkbox"/> W
---	--------------------------------	----------------------	---------------------------	---

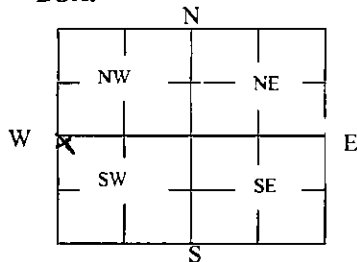
Street/Rural Address of Well Location; if unknown, distance & direction from nearest town or intersection: If at owner's address, check here ☒ 1/2 mile north of Garland corner on US 69.

Global Positioning Systems (GPS) information:

Latitude: 37.73912 (in decimal degrees)
Longitude: 94.70424 (in decimal degrees)
Elevation: 969
Horizontal Datum: ☐ WGS84, ☒ NAD83, ☐ NAD27
Collection Method:

2 WATER WELL OWNER: KDOT
RR#, St. Address, Box #: 700 SW Harrison
City, State ZIP Code: Topeka, KS

☒ GPS unit (Make/Model: Magellan Sport trak)
☐ Digital Map/Photo, ☐ Topographic Map, ☐ Land Survey
Est. Accuracy: ☐ < 3 m. ☐ 3-5 m. ☐ 5-15 m. ☐ > 15 m

3 MARK WELL'S LOCATION WITH AN "X" IN SECTION BOX:

4 DEPTH OF WELL 12 ft.

WELL'S STATIC WATER LEVEL 11 ft

WELL WAS USED AS:

☒ Domestic ☐ Public Water Supply ☐ Dewatering
☐ Irrigation ☐ Oil Field Water Supply ☐ Monitoring
☐ Feedlot ☐ Domestic (Lawn & Garden) ☐ Injection Well
☐ Industrial ☐ Air Conditioning ☐ Other

Was a chemical/bacteriological sample submitted to Department? Yes ☐ No ☒

5 TYPE OF BLANK CASING USED:

☐ Steel ☐ RMP (SR) ☐ Wrought ☐ Fiberglass ☒ Other (Specify below)
☐ PVC ☐ ABS ☐ Asbestos-Cement ☐ Concrete Tile Rock lined

Blank casing diameter 84 in. Was casing pulled? Yes ☒ No ☐ If yes, how much 3 ft
Casing height above or below land surface 36 in.

6 GROUT PLUG MATERIAL: ☐ Neat cement ☐ Cement grout ☐ Bentonite ☒ Other Flowable Fill

Grout Plug Intervals: From 12 ft. to 9 ft., From _____ ft. to _____ ft., From _____ ft. to _____ ft.

What is the nearest source of possible contamination:

☐ Septic tank ☐ Seepage pit ☐ Fuel storage ☒ Other (specify below)
☐ Sewer lines ☐ Pit privy ☐ Fertilizer storage Highway drainage ditch
☐ Watertight sewer lines ☐ Sewage lagoon ☐ Insecticide storage
☐ Lateral lines ☐ Feedyard ☐ Abandoned water well Direction from well? East
☐ Cess pool ☐ Livestock pens ☐ Oil well/Gas well How many feet? 15

FROM	TO	PLUGGING MATERIALS	FROM	TO	PLUGGING MATERIALS
12	3	Flowable Fill			Pam Chaffee witnessed plugging.
3	0	Rock from well lining and soil			
		Well plugged during construction on			
		New US69 highway . Well not			
		recorded, was discovered during			
		construction. Plugging method			
		approved by KDHE.			

7 CONTRACTOR'S OR LANDOWNER'S CERTIFICATION: This water well was plugged under my jurisdiction and was completed on (mo/day/year) 6/22/2017 and this record is true to the best of my knowledge and belief. Kansas Water Well Contractor's License No. 841. This Water Well Record was completed on (mo/day/year) 6/23/2017 under the business name of Double J Energy by (signature) [Signature]

Send one white copy to Kansas Department of Health & Environment, Geology Section, 1000 SW Jackson Street, Ste. 420, Topeka, KS 66612-1367. Send one copy to WATER WELL OWNER and retain one for your records.
Visit us at <http://www.kdheks.gov/waterwell/index.html> Telephone 785-296-5524.

KSA82a-1212
Revised 1/20/2015

New Ground Excavation

