

WATER WELL PLUGGING RECORD

Form WWC-5P

KSA 82a-1212

ID NO.

MW6

1 LOCATION OF WATER WELL:

County: Bourbon

Fraction

NE 1/4 SE 1/4 NE 1/4 NE 1/4

Section Number

6

Township Number

T

26

S

Range Number

25

☒ E☐ W

Street/Rural Address of Well Location; if unknown, distance & direction from nearest town or intersection: If at owner's address, check here ☐

1920 S. Main, Fort Scott, KS

Global Positioning Systems (GPS) information:

Latitude: 37.81748

(in decimal degrees)

Longitude: 94.70635

(in decimal degrees)

Elevation: NA

Horizontal Datum

☐ WGS84,☐ NAD83,☐ NAD27

Collection Method:

☐ GPS unit (Make/model: _____)☐ Digital Map/Photo,☐ Topographic Map☐ Land Survey

Est. Accuracy:

☐ <3 m,☐ 3-5 m,☐ 5-15 m,☐ >15 m

2 WATER WELL OWNER:

Pete's Corporation


RR#, St. Address, Box #:

1712 Broadway

City, State ZIP Code:

Parsons, KS 67357

3 MARK WELL'S LOCATION WITH AN "X" IN SECTION BOX:

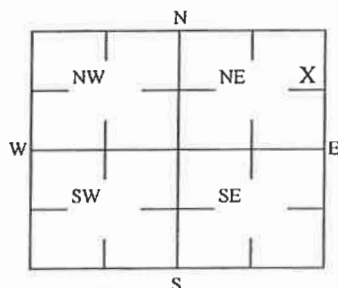

4 DEPTH OF WELL

14.8

ft.

MW6

WELL'S STATIC WATER LEVEL

NA

ft

WELL WAS USED AS:

☐ Domestic
☐ Irrigation
☐ Feedlot
☐ Industrial

☐ Public Water Supply
☐ Oil Field Water Supply
☐ Domestic (Lawn & Garden)
☐ Air Conditioning

☐ Dewatering
☒ Monitoring
☐ Injection Well
☐ Other _____

Was a chemical/bacteriological sample submitted to Department?

Yes ☐ No ☒

5 TYPE OF BLANK CASING USED:

☐ Steel
☒ PVC

☐ RMP (SR)
☐ ABS

☐ Wrought
☐ Asbestos-Cement

☐ Fiberglass
☐ Concrete Tile
☐ Other (Specific below) _____

Blank casing diameter 2 in.

Was casing pulled? Yes ☒ No ☐

If yes, how much 3'

Casing height above or below land surface

NA in.

6 GROUT PLUG MATERIAL:

☐ Neat cement☐ Cement grout☒ Bentonite☒ Other

Concrete: 0-0.5'; Soil: 0.5-3'

Grout Plug Intervals: From 0.5 ft to 14.8 ft, From _____ ft to _____ ft, From _____ ft to _____ ft,

What is the nearest source of possible contamination:

☐ Septic tank
☐ Sewer lines
☐ Watertight sewer lines
☐ Lateral lines
☐ Cess pool

☐ Seepage pit
☐ Pit privy
☐ Sewage lagoon
☐ Feed yard
☐ Livestock pens

☐ Fuel storage
☐ Fertilizer storage
☐ Insecticide storage
☐ Abandoned water well
☐ Oil well/Gas well
☐ Other (specify below) _____

Direction from well? _____

How many feet? _____

FROM	TO	PLUGGING MATERIALS	FROM	TO	PLUGGING MATERIALS
0	0.5	Concrete			
0.5	3	Soil			
0.5	14.8	Bentonite			

KDHE ID:

Pump N Pete's #14; U3-006-14721

7 CONTRACTOR'S OR LANDOWNER'S CERTIFICATION:

This water well was plugged under my jurisdiction and was completed on (mo/day/year) 11/27/2019 and this record is true to the best of my knowledge and belief. Kansas Water Contractor's License No. 757. This Water Well Record was completed on (mo/day/year) 12/4/19 under the business name of Larsen & Associates, Inc. By (signature) _____

Send one white copy to Kansas Department of Health & Environment, Geology Section, 900 SW Jackson Street, Ste. 420, Topeka, KS

66612-1367. Send one copy to WATER WELL OWNER and retain one for your records

Visit us at <http://www.kdheks.gov/waterwell/index.html> Telephone 785-296-5524.

KSA82a-1212

Revised 1/20/2015

NOTE: Figures exhibited within this report are only to be used within the context of this report. Placement of property lines, wells, structures, and roads is based on the available information from county appraiser maps, surveys, site visits, and/or previous vendor reports and should be considered approximate.

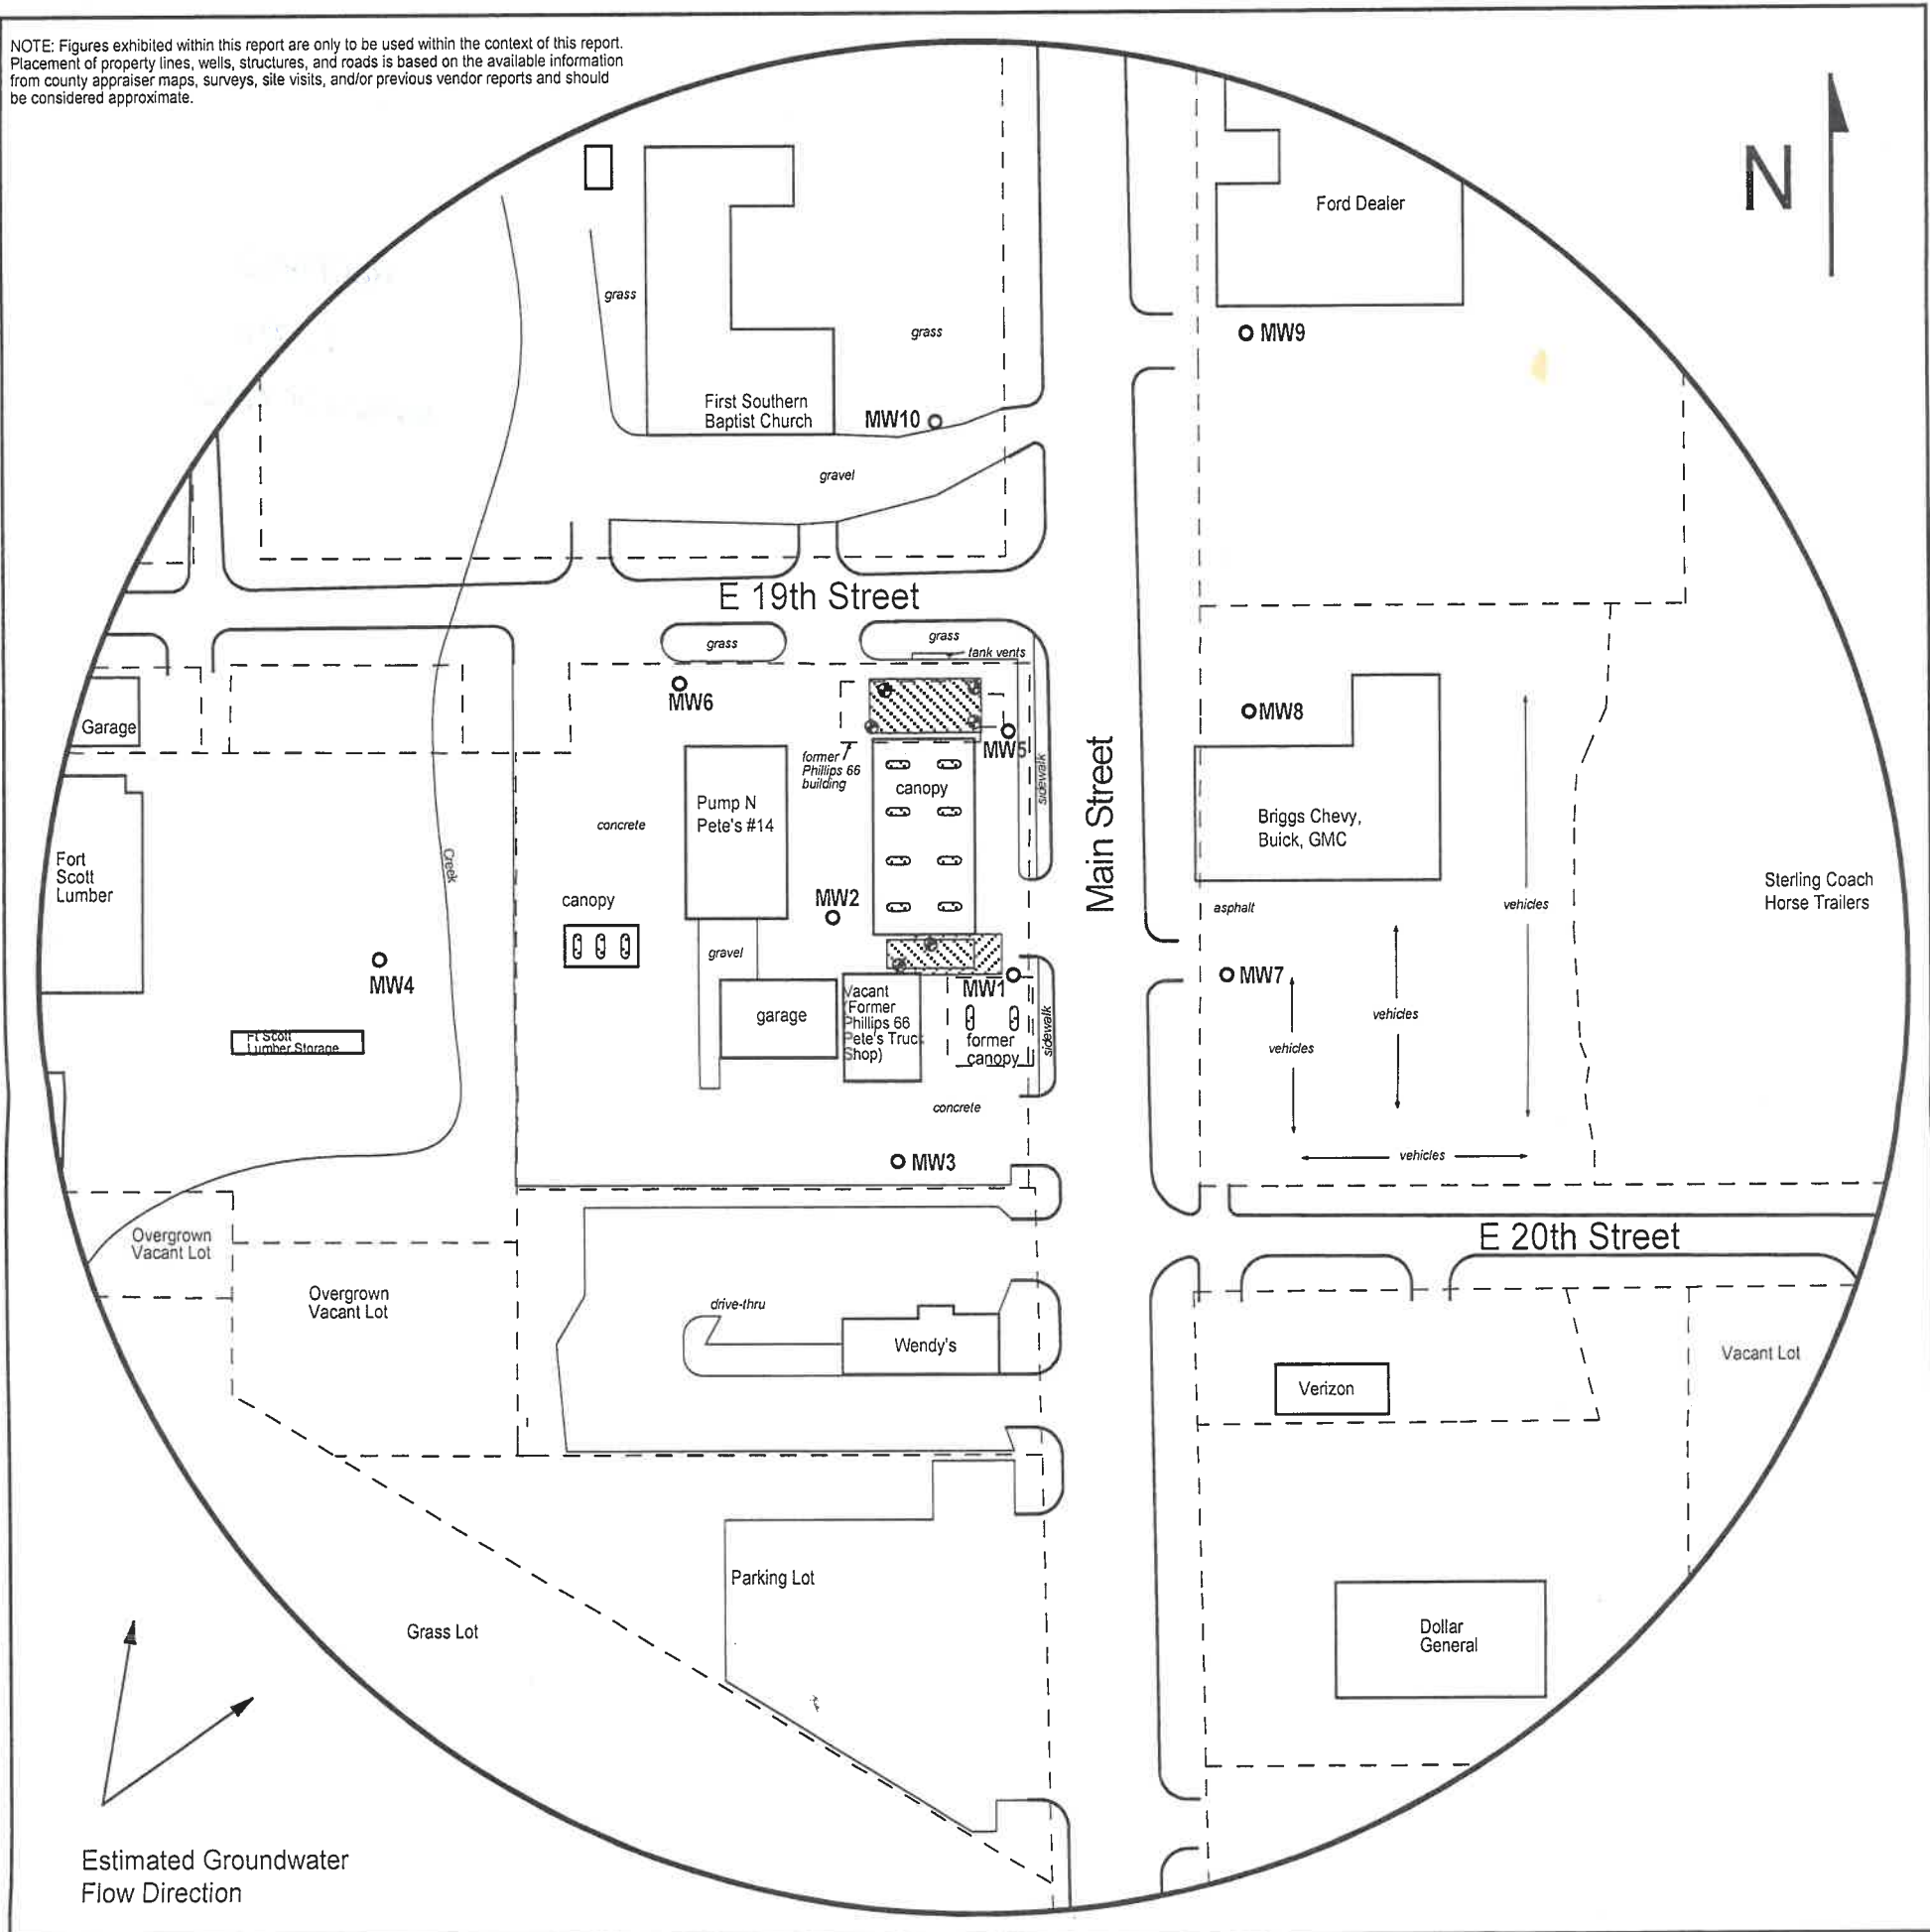


FIGURE 1 - 500 FT RADIUS AREA BASE MAP



PROJECT:
Pump N Pete's #14
1920 S. Main
Fort Scott, KS
KDHE ID: U3-006-14721
Date: 11/27/19

1311 E 25th St., Suite B (785) 841-8707 office
Lawrence, KS 66046 (785) 865-4282 fax



LEGEND:

- Approximate Location of Former UST Basin and Pump Islands
- Approximate Location of Active UST Basin and Pump Islands
- Approximate Location of Property Lines
- Observation Well
- Plugged Monitoring Well

NOTE: Utility depths, heights and locations are approximate.
NOTE: Approximate location of former and active product lines is unknown.