

WATER WELL PLUGGING RECORD Form WWC-5P

KSA 82a-1212

ID NO.

MW-2

1 **LOCATION OF WATER WELL:** Fraction N 2 1/4 NE 1/4 NW 1/4 SW 1/4 Section Number 13 Township Number T 26 S Range Number 25 ☒ E ☐ W
County: Bourbon

Street/Rural Address of Well Location; if unknown, distance & direction from nearest town or intersection: If at owner's address, check here ☐ Custom Alloy Industrial Landfill
847 260th Road
Fort Scott, KS 66701


Global Positioning Systems (GPS) information:

Latitude: 37.782972 (in decimal degrees)
Longitude: -094.6289691 (in decimal degrees)
Elevation: 836.20
Horizontal Datum: ☐ WGS84, ☒ NAD83, ☐ NAD27
Collection Method:

2 **WATER WELL OWNER:** Custom Alloy Sales LF, LLC
RR#, St. Address, Box #: 13191 Crossroads Pkwy, #375
City, State ZIP Code: City of Industry, CA 91746

☐ GPS unit (Make/Model: _____)
☐ Digital Map/Photo, ☐ Topographic Map, ☒ Land Survey
Est. Accuracy: ☒ < 3 m, ☐ 3-5 m, ☐ 5-15 m, ☐ > 15 m

3 MARK WELL'S LOCATION WITH AN "X" IN SECTION BOX:

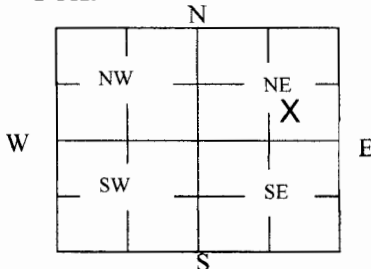

4 DEPTH OF WELL 25.88 ft.

WELL'S STATIC WATER LEVEL 11.92 ft

WELL WAS USED AS:

☐ Domestic ☐ Public Water Supply ☒ Dewatering
☐ Irrigation ☐ Oil Field Water Supply ☐ Monitoring
☐ Feedlot ☐ Domestic (Lawn & Garden) ☐ Injection Well
☐ Industrial ☐ Air Conditioning ☐ Other _____

Was a chemical/bacteriological sample submitted to Department? Yes ☐ No ☒

5 TYPE OF BLANK CASING USED:

☐ Steel ☐ RMP (SR) ☐ Wrought ☐ Fiberglass ☐ Other (Specify below)
☒ PVC ☐ ABS ☐ Asbestos-Cement ☐ Concrete Tile

Blank casing diameter 2 in. Was casing pulled? Yes ☒ No ☐ If yes, how much All Casing Removed
Casing height above or below land surface _____ in.

6 GROUT PLUG MATERIAL: ☐ Neat cement ☐ Cement grout ☒ Bentonite ☐ Other _____

Grout Plug Intervals: From _____ ft. to _____ ft., From _____ ft. to _____ ft., From _____ ft. to _____ ft.

What is the nearest source of possible contamination:

☐ Septic tank ☐ Seepage pit ☐ Fuel storage ☒ Other (specify below)
☐ Sewer lines ☐ Pit privy ☐ Fertilizer storage ☐ Landfill
☐ Watertight sewer lines ☐ Sewage lagoon ☐ Insecticide storage
☐ Lateral lines ☐ Feedyard ☐ Abandoned water well Direction from well? West
☐ Cess pool ☐ Livestock pens ☐ Oil well/Gas well How many feet? 65

FROM	TO	PLUGGING MATERIALS	FROM	TO	PLUGGING MATERIALS
25.88	2	Bentonite			
2	0	On-Site Soil			

7 **CONTRACTOR'S OR LANDOWNER'S CERTIFICATION:** This water well was plugged under my jurisdiction and was completed on (mo/day/year) 5/20/2021 and this record is true to the best of my knowledge and belief. Kansas P.E. Well Contractor's License No. 13086. This Water Well Record was completed on (mo/day/year) 5/21/2021 under the business name of Engineering Solutions & Design, Inc. by (signature) _____

Send one white copy to Kansas Department of Health & Environment, Geology Section, 1000 SW Jackson Street, Ste. 420, Topeka, KS 66612-1367. Send one copy to WATER WELL OWNER and retain one for your records.

Visit us at <http://www.kdheks.gov/waterwell/index.html> Telephone 785-296-5524.

KSA82a-1212

Revised 1/20/2015