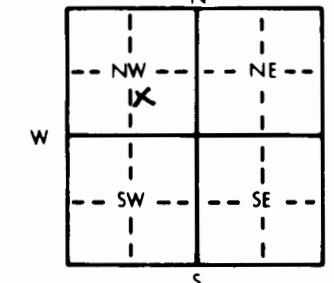


## WATER WELL RECORD Form WWC-5 KSA 82a-1212

1 LOCATION OF WATER WELL: County: <b>BUTLER</b>	Fraction: <b>NW 1/4 SE 1/4 NW 1/4</b>	Section Number: <b>16</b>	Township Number: <b>T 26 S</b>	Range Number: <b>R 3 E</b>	
Distance and direction from nearest town or city street address of well if located within city? <b>AT BENTON ADDREJS</b>					
2 WATER WELL OWNER: RR#, St. Address, Box # : City, State, ZIP Code :	<b>JUANITA COUNCIL 240 W. LITSON BENTON, KS 67017</b>				Board of Agriculture, Division of Water Resource: Application Number:
3 LOCATE WELL'S LOCATION WITH AN "X" IN SECTION BOX:  	4 DEPTH OF COMPLETED WELL: <b>58</b> ft. ELEVATION: <b>55</b> ft. below land surface measured on mo/day/yr <b>6/22/95</b>				
Depth(s) Groundwater Encountered 1. ft. 2. ft. 3. ft. WELL'S STATIC WATER LEVEL .55 ft. below land surface measured on mo/day/yr <b>6/22/95</b> Pump test data: Well water was ft. after hours pumping gpm Est. Yield gpm: Well water was ft. after hours pumping gpm Bore Hole Diameter in. to ft. and in. to ft. WELL WATER TO BE USED AS: 5 Public water supply 8 Air conditioning 11 Injection well 1 Domestic 3 Feedlot 6 Oil field water supply 9 Dewatering 12 Other (Specify below) 2 Irrigation 4 Industrial 7 Lawn and garden only 10 Monitoring well Was a chemical/bacteriological sample submitted to Department? Yes ..... No ..... If yes, mo/day/yr sample was submitted					
5 TYPE OF BLANK CASING USED: 1 Steel 3 RMP (SR) 2 PVC 4 ABS	5 Wrought iron 8 Concrete tile 6 Asbestos-Cement 9 Other (specify below)	CASING JOINTS: Glued ..... Clamped ..... Welded ..... Threaded .....			
Blank casing diameter <b>5</b> in. to ft., Dia. in. to ft., Dia. in. to ft.	lbs./ft. Wall thickness or gauge No.				
Casing height above land surface <b>0</b> in., weight					
TYPE OF SCREEN OR PERFORATION MATERIAL: 1 Steel 3 Stainless steel 5 Fiberglass 7 PVC 10 Asbestos-cement 2 Brass 4 Galvanized steel 6 Concrete tile 9 ABS 11 Other (specify) <b>NA</b> 12 None used (open hole)					
SCREEN OR PERFORATION OPENINGS ARE: 1 Continuous slot 3 Mill slot 5 Gauzed wrapped 8 Saw cut 11 None (open hole) 2 Louvered shutter 4 Key punched 6 Wire wrapped 9 Drilled holes 7 Torch cut 10 Other (specify) <b>NA</b>					
SCREEN-PERFORATED INTERVALS: From <b>NA</b> ft. to ft., From ..... ft. to ..... ft. From ..... ft. to ..... ft., From ..... ft. to ..... ft.					
GRAVEL PACK INTERVALS: From ..... ft. to ..... ft., From ..... ft. to ..... ft. From ..... ft. to ..... ft., From ..... ft. to ..... ft.					
6 GROUT MATERIAL: 1 Neat cement 2 Cement grout 3 Bentonite 4 Other					
Grout Intervals: From <b>30</b> ft. to <b>0</b> ft., From ..... ft. to ..... ft., From ..... ft. to ..... ft.					
What is the nearest source of possible contamination: 1 Septic tank 4 Lateral lines 7 Pit privy 10 Livestock pens 14 Abandoned water well 2 Sewer lines 5 Cess pool 8 Sewage lagoon 11 Fuel storage 15 Oil well/Gas well 3 Watertight sewer lines 6 Seepage pit 9 Feedyard 12 Fertilizer storage 16 Other (specify below)					
Direction from well?					
FROM	TO	LITHOLOGIC LOG	FROM	TO	
				PLUGGING INTERVALS	
			<b>58</b>	<b>30 BENTONITE SAND</b>	
			<b>30</b>	<b>0 BENTONITE</b>	
7 CONTRACTOR'S OR LANDOWNER'S CERTIFICATION: This water well was (1) constructed, (2) reconstructed, or (3) plugged under my jurisdiction and was completed on (mo/day/year) <b>6/22/95</b> and this record is true to the best of my knowledge and belief. Kansas Water Well Contractor's License No. <b>76022795</b> This Water Well Record was completed on (mo/day/year) <b>6/22/95</b> by (signature) <b>Flint Hills Windmill</b>					