WATER WELL RECORD Form WWC-5 KSA 82a-1212

1 LOCATION OF WATER WELL:	Fraction	Section Number	Township Number	Range Number
County: Butler	NW ¼ NW ¼ NW ¼	17	T 26 S	R 3e E/W

Distance and direction from nearest town or city street address of well if located within city?

One mile west of Benton, Kansas on K-254 Monitor Well #2 (See map)

2 WATER WELL OWNER: KDOT , Attn: Kevin Adams, Bureau of Design

RR#, St. Address, Box # : Docking State Office Bldg.

City, State, ZIP Code : Topeka, Kansas 66612

Board of Agriculture, Division of Water Resources Application Number: None

3 LOCATE WELL'S LOCATION WITH AN "X" IN SECTION BOX:

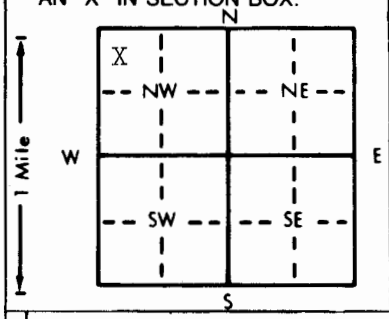

4 DEPTH OF COMPLETED WELL 19.5' ft. ELEVATION:

Depth(s) Groundwater Encountered 1. 15.9 ft. 2. ft. 3. ft.

WELL'S STATIC WATER LEVEL 15.9 ft. below land surface measured on mo/day/yr 4/19/96

Pump test data: Well water was ft. after hours pumping gpm

Est. Yield gpm: Well water was ft. after hours pumping gpm

Bore Hole Diameter in. to ft., and in. to ft.

WELL WATER TO BE USED AS: 10 5 Public water supply 8 Air conditioning 11 Injection well

1 Domestic 3 Feedlot 6 Oil field water supply 9 Dewatering 12 Other (Specify below)

2 Irrigation 4 Industrial 7 Lawn and garden only 10 Monitoring well

Was a chemical/bacteriological sample submitted to Department? Yes No X ; If yes, mo/day/yr sample was submitted Water Well Disinfected? Yes X No

5 TYPE OF BLANK CASING USED: 2 5 Wrought iron 8 Concrete tile CASING JOINTS: Glued Clamped

1 Steel 3 RMP (SR) 6 Asbestos-Cement 9 Other (specify below) Welded

2 PVC 4 ABS 7 Fiberglass Threaded

Blank casing diameter 2 in. to ft., Dia in. to ft., Dia in. to ft.

Casing height above land surface 36 in., weight Sched. 40 lbs./ft. Wall thickness or gauge No.

TYPE OF SCREEN OR PERFORATION MATERIAL: 7 7 PVC 10 Asbestos-cement

1 Steel 3 Stainless steel 5 Fiberglass 8 RMP (SR) 11 Other (specify)

2 Brass 4 Galvanized steel 6 Concrete tile 9 ABS 12 None used (open hole)

SCREEN OR PERFORATION OPENINGS ARE: 3 5 Gauzed wrapped 8 Saw cut 11 None (open hole)

1 Continuous slot 3 Mill slot 6 Wire wrapped 9 Drilled holes

2 Louvered shutter 4 Key punched 7 Torch cut 10 Other (specify)

SCREEN-PERFORATED INTERVALS: From 19.5 ft. to 9.5' ft., From ft. to ft.

From ft. to ft., From ft. to ft.

GRAVEL PACK INTERVALS: From 19.5 ft. to 8.5' ft., From ft. to ft.

From ft. to ft., From ft. to ft.

6 GROUT MATERIAL: 3 1 Neat cement 2 Cement grout 3 Bentonite 4 Other

Grout Intervals: From 8.5 ft. to Surface ft., From ft. to ft., From ft. to ft.

What is the nearest source of possible contamination:

1 Septic tank 4 Lateral lines 7 Pit privy 10 Livestock pens 14 Abandoned water well

2 Sewer lines 5 Cess pool 8 Sewage lagoon 11 Fuel storage 15 Oil well/Gas well

3 Watertight sewer lines 6 Seepage pit 9 Feedyard 12 Fertilizer storage 16 Other (specify below)

13 Insecticide storage UST. Excavation

Direction from well? How many feet? See attached map

FROM	TO	LITHOLOGIC LOG	FROM	TO	PLUGGING INTERVALS
~~0~~ 0	4	Topsoil	0	9.5	Bentonite
4	15	Clay	19.5	9.5	Chlorinated Sand
15	WTD	Sandy, wet clay			

7 CONTRACTOR'S OR LANDOWNER'S CERTIFICATION: This water well was ~~(1) constructed, (2) reconstructed, or~~ (3) plugged under my jurisdiction and was completed on (mo/day/year) 4/19/96 and this record is true to the best of my knowledge and belief. Kansas Water Well Contractor's License No. na This Water Well Record was completed on (mo/day/yr) 5/30/96 under the business name of Kansas Dept. of Transportation by (signature) [signature]

INSTRUCTIONS: Use typewriter or ball point pen. *PLEASE PRESS FIRMLY* and *PRINT* clearly. Please fill in blanks, underline or circle the correct answers. Send top three copies to Kansas Department of Health and Environment, Bureau of Water, Topeka, Kansas 66620-0001. Telephone: 913-296-5545. Send one to WATER WELL OWNER and retain one for your records.