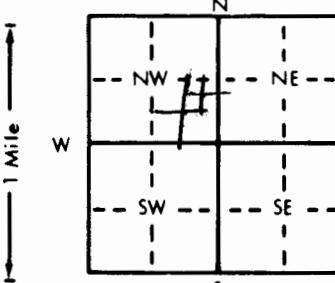


1 LOCATION OF WATER WELL:	Fraction <u>NE 1/4 SE 1/4 NW 1/4</u>	Section Number <u>26</u>	Township Number <u>T 26 S</u>	Range Number <u>R 30 E</u>
Distance and direction from nearest town or city street address of well if located within city? <u>4-W of 4 S of Towanda</u>				
2 WATER WELL OWNER:	<u>Tom Davis Towanda Kan</u>		Board of Agriculture, Division of Water Resources	
RR#, St. Address, Box #	<u>4914 SW Briar Ln, 67144</u>		Application Number:	
City, State, ZIP Code				
3 LOCATE WELL'S LOCATION WITH AN "X" IN SECTION BOX:				
4 DEPTH OF COMPLETED WELL:	<u>125</u> ft. ELEVATION: .....			
Depth(s) Groundwater Encountered	<u>100</u> ft. 2. .... ft. 3. .... ft.			
WELL'S STATIC WATER LEVEL	<u>85</u> ft. below land surface measured on mo/day/yr			
Pump test data: Well water was	ft. after	hours pumping	gpm	
Est. Yield <u>40</u> gpm	ft. after	hours pumping	gpm	
Bore Hole Diameter <u>9.2</u> in. to	ft., and	in. to	ft.	
WELL WATER TO BE USED AS:	5 Public water supply	8 Air conditioning	11 Injection well	
1 Domestic	3 Feedlot	6 Oil field water supply	9 Dewatering	
2 Irrigation	4 Industrial	7 Lawn and garden only	10 Monitoring well	
Was a chemical/bacteriological sample submitted to Department? Yes <input checked="" type="checkbox"/> No <input checked="" type="checkbox"/> If yes, mo/day/yr sample was submitted				
Water Well Disinfected? Yes <input checked="" type="checkbox"/> No <input type="checkbox"/>				
5 TYPE OF BLANK CASING USED:	CASING JOINTS: Glued <input checked="" type="checkbox"/> Clamped <input type="checkbox"/>			
1 Steel	3 RMP (SR)	5 Wrought iron	8 Concrete tile	Welded .....
<input checked="" type="checkbox"/> PVC	4 ABS	6 Asbestos-Cement	9 Other (specify below)	Threaded .....
Blank casing diameter <u>3</u> in. to <u>60</u> ft., Dia.	in. to	ft., Dia.	in. to	ft.
Casing height above land surface <u>18</u> in., weight <u>160</u> lbs./ft. Wall thickness or gauge No. <u>1214</u>				
TYPE OF SCREEN OR PERFORATION MATERIAL:	PVC			
1 Steel	3 Stainless steel	5 Fiberglass	8 RMP (SR)	10 Asbestos-cement
2 Brass	4 Galvanized steel	6 Concrete tile	9 ABS	11 Other (specify) .....
SCREEN OR PERFORATION OPENINGS ARE:	5 Gauzed wrapped			
1 Continuous slot	3 Mill slot	6 Wire wrapped	8 Saw cut	11 None (open hole)
2 Louvered shutter	4 Key punched	7 Torch cut	9 Drilled holes	12 None used (open hole)
SCREEN-PERFORATED INTERVALS: From <u>60</u> ft. to <u>125</u> ft., From .....	ft. to	ft., From .....	ft. to	ft.
GRAVEL PACK INTERVALS: From .....	ft. to .....	ft., From .....	ft. to .....	ft.
From .....	ft. to .....	ft., From .....	ft. to .....	ft.
6 GROUT MATERIAL: 1 Neat cement	2 Cement grout	3 Bentonite	4 Other .....	
Grout Intervals: From <u>3</u> ft. to <u>23</u> ft., From .....	ft. to .....	ft., From .....	ft. to .....	ft.
What is the nearest source of possible contamination:	10 Livestock pens			
1 Septic tank	4 Lateral lines	7 Pit privy	11 Fuel storage	14 Abandoned water well
2 Sewer lines	5 Cess pool	8 Sewage lagoon	12 Fertilizer storage	15 Oil well/Gas well
3 Watertight sewer lines	6 Seepage pit	9 Feedyard	13 Insecticide storage	16 Other (specify below) .....
Direction from well?	How many feet? <u>155</u>			
FROM	TO	LITHOLOGIC LOG		PLUGGING INTERVALS
<u>0</u>	<u>4</u>	<u>Soil</u>		
<u>4</u>	<u>6</u>	<u>Rock</u>		
<u>6</u>	<u>8</u>	<u>Silt</u>		
<u>8</u>	<u>24</u>	<u>Silt</u>		
<u>24</u>	<u>125</u>	<u>Shale + Lime</u>		
7 CONTRACTOR'S OR LANDOWNER'S CERTIFICATION: This water well was <u>1</u> constructed, (2) reconstructed, or (3) plugged under my jurisdiction and was completed on (mo/day/year) <u>6/17/96</u>	and this record is true to the best of my knowledge and belief. Kansas			
Water Well Contractor's License No. <u>257</u>	This Water Well Record was completed on (mo/day/year) <u>6/29/96</u>			
under the business name of <u>Winter Well Drill</u>	by (signature) <u>Charles Winter</u>			