

1 LOCATION OF WATER WELL:		Fraction	Section Number	Township Number	Range Number
County: <i>Butler</i>		<i>SW 1/4 SE 1/4 NW 1/4</i>	<i>16</i>	<i>T 26 S</i>	<i>R 3 E</i>


Distance and direction from nearest town or city street address of well if located within city?

420 N Ohio Benton

2	WATER WELL OWNER:	Vernon E Hopkins	
	RR#, St. Address, Box # :	420 N. Ohio	Board of Agriculture, Division of Water Resources
	City, State, ZIP Code :	Benton, KS 67017	Application Number:

3 LOCATE WELL'S LOCATION WITH AN "X" IN SECTION BOX:

4 DEPTH OF COMPLETED WELL.....110..... ft. ELEVATION:

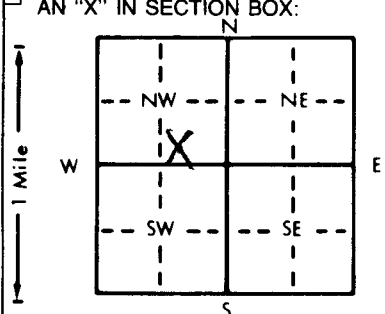

Depth(s) Groundwater Encountered 1. 40 ft. 2. _____ ft. 3. _____ ft.

WELL'S STATIC WATER LEVEL . . . 22 . . . ft. below land surface measured on mo/day/yr

Pump test data: Well water was ft. after hours pumping gpm

Est. Yield . . . 6 . . . gpm: Well water was ft. after hours pumping gpm

Bore Hole Diameter . . . 10 . . . in. to ft., and in. to ft.

WELL WATER TO BE USED AS:	5 Public water supply	8 Air conditioning	11 Injection well
---------------------------	-----------------------	--------------------	-------------------

1 Domestic	3 Feedlot	6 Oil field water supply	9 Dewatering	12 Other (Specify below)
------------	-----------	--------------------------	--------------	--------------------------

2 Irrigation 4 Industrial ☒ Lawn and garden only 10 Monitoring well

Was a chemical/bacteriological sample submitted to Department? Yes.....No.....; If yes, mo/day/yr sample was sub-

mitted	Water Well Disinfected? Yes	No
--------	-----------------------------	----

5	TYPE OF BLANK CASING USED:		5 Wrought iron	8 Concrete tile	CASING JOINTS: Glued <input checked="" type="checkbox"/> Clamped
	1 Steel	3 RMP (SR)	6 Asbestos-Cement	9 Other (specify below)	Welded
	2 PVC	4 ABS	7 Fiberglass		Threaded

Blank casing diameter 5 in. to 5 ft. Dia 5 in. to 5 ft. Dia 5 in. to 5 ft.

Casing height above land surface 12 in., weight 160 lbs./ft. Wall thickness or gauge No. _____

TYPE OF SCREEN OR PERFORATION MATERIAL: ☒ PVC ☐ 10 Asbestos-cement

1 Steel	3 Stainless steel	5 Fiberglass	8 RMP (SR)	11 Other (specify)
---------	-------------------	--------------	------------	--------------------------

2 Brass	4 Galvanized steel	6 Concrete tile	9 ABS	12 None used (open hole)
---------	--------------------	-----------------	-------	--------------------------

SCREEN OR PERFORATION OPENINGS ARE: 5 Gauzed wrapped 8 Saw cut 11 None (open hole)

1 Continuous slot	<u>3</u> Mill slot	6 Wire wrapped	9 Drilled holes
-------------------	--------------------	----------------	-----------------

2 Louvered shutter 4 Key punched 7 Torch cut 10 Other (specify)

SCREEN-PERFORATED INTERVALS: From 90 ft. to 160 ft., From _____ ft. to _____ ft.

From ft. to ft., From ft. to ft.

GRAVEL PACK INTERVALS: From 20 ft. to 110 ft., From _____ ft. to _____ ft.

From _____ ft. to _____ ft., From _____ ft. to _____ ft.

6 GROUT MATERIAL: 1 Neat cement 2 Cement grout 3 Bentonite 4 Other
Grout Intervals: From 4 ft. to 20 ft. From ft. to ft. From ft. to ft.

What is the nearest source of possible contamination: 10 Livestock pens 14 Abandoned water well

1 Septic tank	4 Lateral lines	7 Pit privy	11 Fuel storage	15 Oil well/Gas well
---------------	-----------------	-------------	-----------------	----------------------

2 Sewer lines	5 Cess pool	8 Sewage lagoon	12 Fertilizer storage	16 Other (specify below)
---------------	-------------	-----------------	-----------------------	--------------------------

9 Watertight sewer lines	6 Seepage pit	9 Feedyard	13 Insecticide storage
--------------------------	---------------	------------	------------------------	-------

Direction from well? South How many feet? 20

FROM	TO	LITHOLOGIC LOG	FROM	TO	PLUGGING INTERVALS
------	----	----------------	------	----	--------------------

0	4	earth			
4	32	brown clay			
32	35	green shale			
35	39	red bed			
39	45	shale + lime			
45	70	gray shale			
70	110	shale light & Dark			

7. CONTRACTOR'S OR LANDOWNER'S CERTIFICATION: This water well was (1) constructed, (2) reconstructed, or (3) plugged under my jurisdiction and was completed on (mo/day/year) 3/3/24 and this record is true to the best of my knowledge and belief. Kansas Water Well Contractor's License No. 493 This Water Well Record was completed on (mo/day/yr) 3/3/24 under the business name of Reiserer Well Drilling by (signature) Jeremy Reiserer