


1 LOCATION OF WATER WELL:		Fraction			Section Number		Township Number		Range Number				
County:	Butler	1/4	NW	1/4	NE	1/4	12	T	26	S	R	3E	E/W

Distance and direction from nearest town or city street address of well if located within city?  
11459 SW 15th St., Benton, KS

2	WATER WELL OWNER: Gene Gordineer	
	RR#, St. Address, Box # : 11459 SW 15th St.	Board of Agriculture, Division of Water Resources
	City, State, ZIP Code : Benton, KS 67017	Application Number:

3 LOCATE WELL'S LOCATION WITH AN "X" IN SECTION BOX: 4 DEPTH OF COMPLETED WELL: 100 ft. ELEVATION:  
Depth(s) Groundwater Encountered 1. ft. 2. ft. 3. ft.

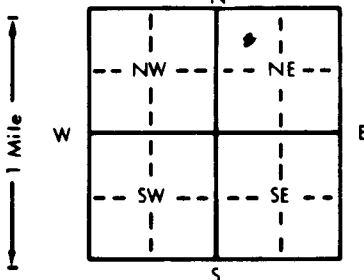

4) DEPTH OF COMPLETED WELL.....100..... ft. ELEVATION:.....  
 Depth(s) Groundwater Encountered 1..... ft. 2..... ft. 3..... ft.  
 WELL'S STATIC WATER LEVEL.....12..... ft. below land surface measured on mo/day/yr.....7/8/99.....  
 Pump test data: Well water was..... ft. after..... hours pumping..... gpm  
 Est. Yield..... gpm: Well water was..... ft. after..... hours pumping..... gpm  
 Bore Hole Diameter.....9..... in. to.....100..... ft., and..... in. to..... ft.  
 WELL WATER TO BE USED AS: 5 Public water supply 8 Air conditioning 11 Injection well  
 ① Domestic 3 Feedlot 6 Oil field water supply 9 Dewatering 12 Other (Specify below)  
 2 Irrigation 4 Industrial 7 Lawn and garden only 10 Monitoring well.....  
 Was a chemical/bacteriological sample submitted to Department? Yes.....No...X.....; If yes, mo/day/yr sample was submitted  
 Water Well Disinfected? Yes X No

5	TYPE OF BLANK CASING USED:	5 Wrought iron	8 Concrete tile	CASING JOINTS: Glued . . . <u>X</u> . . . Clamped . . . . .
	1 Steel	3 RMP (SR)	6 Asbestos-Cement	9 Other (specify below)
	② PVC	4 ABS	7 Fiberglass	Welded . . . . .
				Threaded . . . . .

Blank casing diameter . . . . . 5 . . . . in. to . . . . 80 . . . . ft., Dia . . . . in. to . . . . ft., Dia . . . . in. to . . . . ft.  
Casing height above land surface . . . . 12 . . . . in., weight . . . . lbs./ft. Wall thickness or gauge No. SDR26

TYPE OF SCREEN OR PERFORATION MATERIAL:			⑦ PVC	10 Asbestos-cement
1 Steel	3 Stainless steel	5 Fiberglass	8 RMP (SR)	11 Other (specify) .....
2 Brass	4 Galvanized steel	6 Concrete tile	9 ABS	12 None used (open hole)

SCREEN OR PERFORATION OPENINGS ARE:		5 Gauzed wrapped	8 Saw cut	11 None (open hole)
1 Continuous slot	3 Mill slot	6 Wire wrapped	9 Drilled holes	
2 Louvered shutter	4 Key punched	7 Torch cut	10 Other (specify) .....	

SCREEN-PERFORATED INTERVALS:	From . . . . . 80 . . . . . ft. to . . . . . 100 . . . . . ft.,	From . . . . . ft. to . . . . . ft.
	From . . . . . ft. to . . . . . ft.,	From . . . . . ft. to . . . . . ft.
GRAVEL PACK INTERVALS:	From . . . . . 20 . . . . . ft. to . . . . . 100 . . . . . ft.,	From . . . . . ft. to . . . . . ft.
	From . . . . . ft. to . . . . . ft.,	From . . . . . ft. to . . . . . ft.

6. GROUT MATERIAL: 1 Neat cement 2 Cement grout 3 Bentonite 4 Other \_\_\_\_\_  
Grout Intervals: From 4 ft. to 20 ft., From \_\_\_\_\_ ft. to \_\_\_\_\_ ft., From \_\_\_\_\_ ft. to \_\_\_\_\_ ft.

What is the nearest source of possible contamination:

1 Septic tank	4 Lateral lines	7 Pit privy	10 Livestock pens	14 Abandoned water well
2 Sewer lines	5 Cess pool	8 Sewage lagoon	11 Fuel storage	15 Oil well/Gas well
3 Watertight sewer lines	6 Seepage pit	9 Feedyard	12 Fertilizer storage	16 Other (specify below)
Direction from well?			13 Insecticide storage	.....
			How many feet?	.....

Direction from well?				FROM:	How many feet?	PULLING INTERVAL
EAST	50'	NORTH	100'	FROM:		

[illegible]

7. CONTRACTOR'S OR LANDOWNER'S CERTIFICATION: This water well was (1) constructed, (2) reconstructed, or (3) plugged under my jurisdiction and was completed on (mo/day/year) 7/8/99 and this record is true to the best of my knowledge and belief. Kansas Water Well Contractor's License No. 171 This Water Well Record was completed on (mo/day/yr) 8/2/99 under the business name of G&S Drilling, Inc. by (signature) 