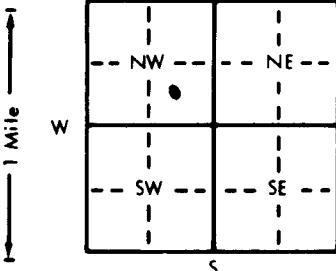


1 LOCATION OF WATER WELL:	Fraction C $\frac{1}{4}$ SE $\frac{1}{4}$ NW $\frac{1}{4}$	Section Number 16	Township Number T 26 S	Range Number R 3E E/W
Distance and direction from nearest town or city street address of well if located within city? 485 N. Norris Benton, KS				
2 WATER WELL OWNER:	Bryan Edson P.O. Box 342			
RR#, St. Address, Box #	Board of Agriculture, Division of Water Resources			
City, State, ZIP Code		Application Number:		
3 LOCATE WELL'S LOCATION WITH AN "X" IN SECTION BOX:		4 DEPTH OF COMPLETED WELL... 80 ft. ELEVATION: .....		
		Depth(s) Groundwater Encountered 1 ft. 2 ft. 3 ft. WELL'S STATIC WATER LEVEL 18 ft. below land surface measured on mo/day/yr Pump test data: Well water was ft. after hours pumping gpm Est. Yield gpm: Well water was ft. after hours pumping gpm Bore Hole Diameter 9 in. to 80 ft., and in. to ft. WELL WATER TO BE USED AS: 5 Public water supply 8 Air conditioning 11 Injection well 1 Domestic 3 Feedlot 6 Oil field water supply 9 Dewatering 12 Other (Specify below) 2 Irrigation 4 Industrial 7 Lawn and garden only 10 Monitoring well Was a chemical/bacteriological sample submitted to Department? Yes..... No..... If yes, mo/day/yr sample was submitted Water Well Disinfected? Yes X No		
5 TYPE OF BLANK CASING USED:		5 Wrought iron 6 Asbestos-Cement 7 Fiberglass	8 Concrete tile 9 Other (specify below)	CASING JOINTS: Glued X Clamped Welded Threaded
Blank casing diameter 5 in. to 60 ft., Dia in. to ft., Dia in. to ft.		Casing height above land surface 12 in., weight lbs./ft. Wall thickness or gauge No. SDR 26		
TYPE OF SCREEN OR PERFORATION MATERIAL:				
1 Steel 2 PVC		3 Stainless steel 4 ABS	5 Fiberglass 6 Concrete tile	7 PVC 8 RMP (SR) 9 ABS
10 Asbestos-cement 11 Other (specify) 12 None used (open hole)				
5 Gauzed wrapped 6 Wire wrapped 7 Torch cut				
8 Saw cut 9 Drilled holes 10 Other (specify)				
SCREEN OR PERFORATION OPENINGS ARE: 1 Continuous slot 2 Louvered shutter 3 Mill slot 4 Key punched				
11 None (open hole)				
SCREEN-PERFORATED INTERVALS: From 60 ft. to 80 ft., From ft. to ft. From ft. to ft., From ft. to ft.				
GRAVEL PACK INTERVALS: From 20 ft. to 80 ft., From ft. to ft., From ft. to ft.				
6 GROUT MATERIAL: 1 Neat cement 2 Cement grout 3 Bentonite 4 Other				
Grout Intervals: From 4 ft. to 20 ft., From ft. to ft., From ft. to ft., From ft. to ft.				
What is the nearest source of possible contamination: 1 Septic tank 2 Sewer lines 3 Watertight sewer lines 4 Lateral lines 5 Cess pool 6 Seepage pit 7 Pit privy 8 Sewage lagoon 9 Feedyard 10 Livestock pens 11 Fuel storage 12 Fertilizer storage 13 Insecticide storage 14 Abandoned water well 15 Oil well/Gas well 16 Other (specify below)				
Direction from well? How many feet?				
FROM	TO	LITHOLOGIC LOG	FROM	TO
0	18	Clay		
18	28	Shale		
28	32	Lime		
32	48	Shale		
48	62	Lime & shale streaks		
62	80	Cherty lime		
7 CONTRACTOR'S OR LANDOWNER'S CERTIFICATION: This water well was (1) constructed, (2) reconstructed, or (3) plugged under my jurisdiction and was completed on (mo/day/year) 4-14-01 and this record is true to the best of my knowledge and belief. Kansas Water Well Contractor's License No. 171 This Water Well Record was completed on (mo/day/year) 4-30-01 under the business name of G&S Drilling, Inc. by (signature) 