


1 LOCATION OF WATER WELL:	Fraction 1/4 C 1/4 NW 1/4	Section Number 14	Township Number T 24 S	Range Number R 3E E/W
---------------------------	------------------------------	----------------------	---------------------------	--------------------------

County: Butler Distance and direction from nearest town or city street address of well if located within city?370 Morris Ct. Benton, KS

2 WATER WELL OWNER:	Mark Pierce	Board of Agriculture, Division of Water Resources
RR#, St. Address, Box # :	P.O. Box 519	Application Number:
City, State, ZIP Code :	Benton, KS 67017	

3 LOCATE WELL'S LOCATION WITH AN "X" IN SECTION BOX:	4 DEPTH OF COMPLETED WELL.....80..... ft. ELEVATION: .....
------------------------------------------------------	------------------------------------------------------------

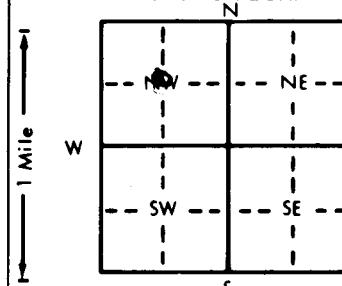

Depth(s) Groundwater Encountered 1..... ft. 2..... ft. 3..... ft.

WELL'S STATIC WATER LEVEL 30 ft. below land surface measured on mo/day/yr 7-18-01

Pump test data: Well water was ..... ft. after ..... hours pumping ..... gpm

Est. Yield ..... gpm: Well water was ..... ft. after ..... hours pumping ..... gpm

Bore Hole Diameter 9 in. to 80 ft., and ..... in. to ..... ft.

WELL WATER TO BE USED AS: 5 Public water supply 8 Air conditioning 11 Injection well

1 Domestic 3 Feedlot 6 Oil field water supply 9 Dewatering 12 Other (Specify below)

2 Irrigation 4 Industrial 7 Lawn and garden only 10 Monitoring well

Was a chemical/bacteriological sample submitted to Department? Yes ..... No  If yes, mo/day/yr sample was submittedWater Well Disinfected? Yes  No

5 TYPE OF BLANK CASING USED:	5 Wrought iron 8 Concrete tile CASING JOINTS: Glued <input checked="" type="checkbox"/> Clamped .....
1 Steel 3 RMP (SR)	6 Asbestos-Cement 9 Other (specify below) Welded .....
<input checked="" type="checkbox"/> PVC 4 ABS	7 Fiberglass Threaded .....

Blank casing diameter 5 in. to 60 ft., Dia ..... in. to ..... ft., Dia ..... in. to ..... ft.

Casing height above land surface 12 in., weight ..... lbs./ft. Wall thickness or gauge No. 70P26

TYPE OF SCREEN OR PERFORATION MATERIAL:	7 PVC 10 Asbestos-cement
-----------------------------------------	--------------------------

1 Steel 3 Stainless steel 5 Fiberglass 8 RMP (SR) 11 Other (specify) .....

2 Brass 4 Galvanized steel 6 Concrete tile 9 ABS 12 None used (open hole)

SCREEN OR PERFORATION OPENINGS ARE:	5 Gauzed wrapped 8 Saw cut 11 None (open hole)
-------------------------------------	------------------------------------------------

1 Continuous slot 3 Mill slot 6 Wire wrapped 9 Drilled holes

2 Louvered shutter 4 Key punched 7 Torch cut 10 Other (specify) .....

SCREEN-PERFORATED INTERVALS:	From 60 ft. to 80 ft., From ..... ft. to ..... ft.
------------------------------	----------------------------------------------------

From ..... ft. to ..... ft., From ..... ft. to ..... ft.

GRAVEL PACK INTERVALS:	From 20 ft. to 80 ft., From ..... ft. to ..... ft.
------------------------	----------------------------------------------------

From ..... ft. to ..... ft., From ..... ft. to ..... ft.

6 GROUT MATERIAL:	1 Neat cement 2 Cement grout 3 Bentonite 4 Other .....
-------------------	--------------------------------------------------------

Grout Intervals: From 1 ft. to 20 ft., From ..... ft. to ..... ft., From ..... ft. to ..... ft.

What is the nearest source of possible contamination:

1 Septic tank 4 Lateral lines 7 Pit privy 10 Livestock pens 14 Abandoned water well

2 Sewer lines 5 Cess pool 8 Sewage lagoon 11 Fuel storage 15 Oil well/Gas well

3 Watertight sewer lines 6 Seepage pit 9 Feedyard 12 Fertilizer storage 16 Other (specify below)

How many feet?

FROM	TO	LITHOLOGIC LOG	FROM	TO	PLUGGING INTERVALS
------	----	----------------	------	----	--------------------

0	18	Clay			
---	----	------	--	--	--

18	32	shale			
----	----	-------	--	--	--

32	34	lime			
----	----	------	--	--	--

34	48	shale			
----	----	-------	--	--	--

48	13	lime w/ shale streaks			
----	----	-----------------------	--	--	--

13	80	clayey lime			
----	----	-------------	--	--	--

--	--	--	--	--	--

--	--	--	--	--	--

</td
------