

1 LOCATION OF WATER WELL:	Fraction	Section Number	Township Number	Range Number
County: <u>Batter</u>	$\frac{1}{4}$ <u>C</u> $\frac{1}{4}$ <u>NW</u> $\frac{1}{4}$	<u>16</u>	T <u>26</u> S	R <u>3E</u> EW

Distance and direction from nearest town or city street address of well if located within city?

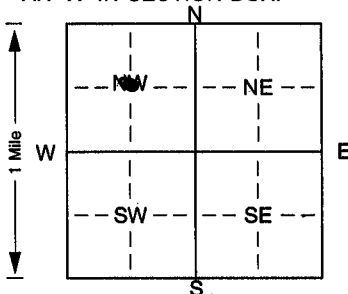
380 Sunflower Lane, Benton, KS2 WATER WELL OWNER: Darrel JohnsonRR#, St. Address, Box # : 380 Sunflower LaneCity, State, ZIP Code : Benton, KS 67017

Board of Agriculture, Division of Water Resources

Application Number:

3 LOCATE WELL'S LOCATION WITH 4 DEPTH OF COMPLETED WELL: 62 ft. ELEVATION: 4-17-02 ft.

AN "X" IN SECTION BOX:


WELL WATER TO BE USED AS: 5 Public water supply 8 Air conditioning 11 Injection well

1 Domestic 3 Feedlot 6 Oil field water supply 9 Dewatering 12 Other (Specify below)

2 Irrigation 4 Industrial 7 Domestic (lawn & garden) 10 Monitoring wellWas a chemical/bacteriological sample submitted to Department? Yes. X No. X; If yes, mo/day/yr sample was submittedWater Well Disinfected? Yes X No5 TYPE OF BLANK CASING USED: 5 Wrought iron 8 Concrete tile CASING JOINTS: Glued X Clamped

1 Steel 3 RMP (SR) 6 Asbestos-Cement 9 Other (specify below) Welded

2 PVC 4 ABS 7 Fiberglass Threaded


TYPE OF SCREEN OR PERFORATION MATERIAL:

1 Steel 3 Stainless steel 5 Fiberglass 7 PVC 10 Asbestos-cement

2 Brass 4 Galvanized steel 6 Concrete tile 8 RMP (SR) 11 Other (specify)

SCREEN OR PERFORATION OPENINGS ARE: 5 Gauzed wrapped 8 Saw cut 11 None (open hole)

1 Continuous slot 3 Mill slot 6 Wire wrapped 9 Drilled holes

2 Louvered shutter 4 Key punched 7 Torch cut 10 Other (specify)

SCREEN-PERFORATED INTERVALS: From 42 ft. to 62 ft., From 42 ft. to 62 ft., From 42 ft. to 62 ft.GRAVEL PACK INTERVALS: From 20 ft. to 62 ft., From 20 ft. to 62 ft., From 20 ft. to 62 ft.From 20 ft. to 62 ft., From 20 ft. to 62 ft., From 20 ft. to 62 ft.6 GROUT MATERIAL: 1 Neat cement 2 Cement grout 3 Bentonite 4 OtherGrout Intervals: From 4 ft. to 20 ft., From 4 ft. to 20 ft., From 4 ft. to 20 ft.

What is the nearest source of possible contamination:

1 Septic tank 4 Lateral lines 7 Pit privy 10 Livestock pens 14 Abandoned water well

2 Sewer lines 5 Cess pool 8 Sewage lagoon 11 Fuel storage 15 Oil well/Gas well

3 Watertight sewer lines 6 Seepage pit 9 Feedyard 12 Fertilizer storage 16 Other (specify below)

Direction from well? How many feet?

FROM TO LITHOLOGIC LOG FROM TO PLUGGING INTERVALS

FROM TO LITHOLOGIC LOG FROM TO PLUGGING INTERVALS

7 CONTRACTOR'S OR LANDOWNER'S CERTIFICATION: This water well was (1) constructed, (2) reconstructed, or (3) plugged under my jurisdiction and was completed on (mo/day/year) 4-17-02 and this record is true to the best of my knowledge and belief. KansasWater Well Contractor's Licence No. 171 This Water Well Record was completed on (mo/day/yr) 4-18-02under the business name of GXS Drilling, Inc. by (signature) [Signature]