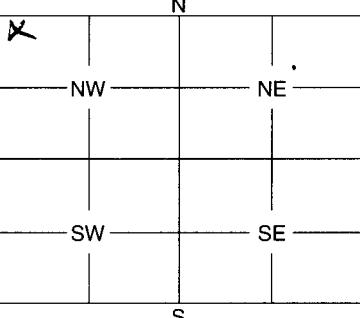


1	LOCATION OF WATER WELL: County: <i>Butcher</i>	Fraction <i>NW NW NW</i>	Section Number <i>35</i>	Township Number <i>26</i>	Range Number <i>3 EW</i>					
2	WATER WELL OWNER: <i>El Paso Corporation 2 North Nevada</i>	Distance and direction from nearest town or city street address of well if located within city? <i>1 Mls North of US 254 Hwy 42 mile west of Bender, KS MW #43</i>								
3	RR #, St. Address, Box #: City, State, ZIP Code : <i>Colorado Springs CO 80903</i>	Board of Agriculture, Division of Water Resources Application Number:								
4	MARK WELL'S LOCATION WITH AN "X" IN SECTION BOX:  	DEPTH OF WELL ..... <i>35</i> ..... ft.	WELL'S STATIC WATER LEVEL ..... ft.	WELL WAS USED AS:						
		1 Domestic 2 Irrigation 3 Feedlot 4 Industrial	5 Public Water Supply 6 Oil Field Water Supply 7 Domestic (Lawn & Garden) 8 Air Conditioning	9 Dewatering <input checked="" type="checkbox"/> Monitoring Well 11 Injection Well 12 Other .....						
5	Was a chemical / bacteriological sample submitted to Department? Yes ..... No ..... If yes, mo/day/yr sample was submitted .....									
	Water Well Disinfected: Yes ..... No .....									
6	TYPE OF BLANK CASING USED: 1 Steel    3 RMP (SR)    5 Wrought    7 Fiberglass    9 Other (Specify below) <input checked="" type="checkbox"/> PVC    4 ABS    6 Asbestos-Cement    8 Concrete Tile .....									
	Blank casing diameter <i>4</i> in.    Was casing pulled? Yes <input checked="" type="checkbox"/> .....    No .....    If yes, how much <i>25</i> ..... Casing height above or below land surface <i>30</i> in.									
7	GROUT PLUG MATERIAL:    1 Neat cement <input checked="" type="checkbox"/> Cement grout    3 Bentonite    4 Other ..... <i>Topsoil</i> ..... Grout Plug Intervals:    From <i>35</i> ft.    to <i>1</i> ft.,    From ..... ft.    to ..... ft.,    From ..... ft.    to ..... ft.									
	What is the nearest source of possible contamination: <table><tr><td>1 Septic tank 2 Sewer lines 3 Watertight sewer lines 4 Lateral lines 5 Cess pool</td><td>6 Seepage pit 7 Pit privy 8 Sewage lagoon 9 Feedyard 10 Livestock pens</td><td><input checked="" type="checkbox"/> Fuel storage 12 Fertilizer storage 13 Insecticide storage 14 Abandoned water well 15 Oil well/Gas well</td><td>16 Other (specify below) .....</td></tr>
	Direction from well? <i>South</i> .....    How many feet? <i>120</i> .....									
	FROM	TO	PLUGGING MATERIALS							
	<i>35</i>	<i>1</i>	<i>CEMENT Grout w 6% Bentonite</i>							
	<i>1</i>	<i>0</i>	<i>Topsoil</i>							
7	CONTRACTOR'S OF LANDOWNER'S CERTIFICATION: This water well was plugged under my jurisdiction and was completed on (mo/day/year) <i>10-15-02</i> ..... and this record is true to the best of my knowledge and belief. Kansas Water Well Contractor's License No. <i>575</i> ..... This Water Well Record was completed on (mo/day/year) <i>11-14-02</i> ..... under the business name of <i>Funke's Oil Well Service Inc.</i> ..... by (signature) <i>W. L. L.</i>									
INSTRUCTIONS: Use typewriter or ball point pen. Please press firmly and print clearly. Please fill in blanks, underline or circle the correct answers. Send top three copies to Kansas Department of Health and Environment, Bureau of Water, Geology Section, 1000 SW Jackson St., Ste. 420, Topeka, Kansas 66612-1367. Telephone: 785/296-5522. Send one to Water Well Owner and retain one for your records.										