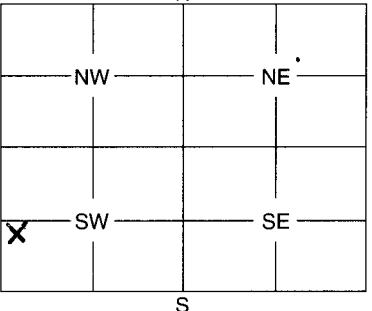


1	LOCATION OF WATER WELL:	Fraction	Section	Number	Township	Number	Range	Number																								
County: Butler		NW <sup>1/4</sup> SW <sup>1/4</sup> SW <sup>1/4</sup>	5		26		3	EW																								
Distance and direction from nearest town or city street address of well if located within city? <i>3 1/4 Miles North of 254 Hwy 3 1/2 Miles West of Benton KS MW# 46</i>																																
2	WATER WELL OWNER:	El Paso Corporation 2 North Nevada																														
RR #, St. Address, Box #: City, State, ZIP Code		Board of Agriculture, Division of Water Resources Application Number:																														
3	MARK WELL'S LOCATION WITH AN "X" IN SECTION BOX:		4 DEPTH OF WELL ..... 26.5 ft.																													
		WELL'S STATIC WATER LEVEL ..... ft.																														
WELL WAS USED AS:																																
<table border="0"> <tr> <td>1 Domestic</td> <td>5 Public Water Supply</td> <td>9 Dewatering</td> </tr> <tr> <td>2 Irrigation</td> <td>6 Oil Field Water Supply</td> <td>10 Monitoring Well</td> </tr> <tr> <td>3 Feedlot</td> <td>7 Domestic (Lawn &amp; Garden)</td> <td>11 Injection Well</td> </tr> <tr> <td>4 Industrial</td> <td>8 Air Conditioning</td> <td>12 Other .....</td> </tr> </table>									1 Domestic	5 Public Water Supply	9 Dewatering	2 Irrigation	6 Oil Field Water Supply	10 Monitoring Well	3 Feedlot	7 Domestic (Lawn & Garden)	11 Injection Well	4 Industrial	8 Air Conditioning	12 Other .....												
1 Domestic	5 Public Water Supply	9 Dewatering																														
2 Irrigation	6 Oil Field Water Supply	10 Monitoring Well																														
3 Feedlot	7 Domestic (Lawn & Garden)	11 Injection Well																														
4 Industrial	8 Air Conditioning	12 Other .....																														
Was a chemical / bacteriological sample submitted to Department? Yes ..... No ..... If yes, mo/day/yr sample was submitted .....																																
Water Well Disinfected: Yes ..... No .....																																
5	TYPE OF BLANK CASING USED:																															
<table border="0"> <tr> <td>1 Steel</td> <td>3 RMP (SR)</td> <td>5 Wrought</td> <td>7 Fiberglass</td> <td>9 Other (Specify below)</td> </tr> <tr> <td><input checked="" type="radio"/> PVC</td> <td>4 ABS</td> <td>6 Asbestos-Cement</td> <td>8 Concrete Tile</td> <td>.....</td> </tr> </table>									1 Steel	3 RMP (SR)	5 Wrought	7 Fiberglass	9 Other (Specify below)	<input checked="" type="radio"/> PVC	4 ABS	6 Asbestos-Cement	8 Concrete Tile	.....														
1 Steel	3 RMP (SR)	5 Wrought	7 Fiberglass	9 Other (Specify below)																												
<input checked="" type="radio"/> PVC	4 ABS	6 Asbestos-Cement	8 Concrete Tile	.....																												
Blank casing diameter ..... in. Was casing pulled? Yes <input checked="" type="checkbox"/> No ..... If yes, how much ..... 16.5																																
Casing height above or below land surface ..... 33 in.																																
6	GROUT PLUG MATERIAL: 1 Neat cement <input checked="" type="radio"/> Cement grout 3 Bentonite <input checked="" type="radio"/> Other ..... Top seal.																															
Grout Plug Intervals: From ..... 26.5 ft. to ..... 1 ft., From ..... ft. to ..... ft., From ..... 1 ft. to ..... 0 ft.																																
What is the nearest source of possible contamination:																																
<table border="0"> <tr> <td>1 Septic tank</td> <td>6 Seepage pit</td> <td>11 Fuel storage</td> <td>16 Other (specify below)</td> </tr> <tr> <td>2 Sewer lines</td> <td>7 Pit privy</td> <td>12 Fertilizer storage</td> <td>.....</td> </tr> <tr> <td>3 Watertight sewer lines</td> <td>8 Sewage lagoon</td> <td>13 Insecticide storage</td> <td>.....</td> </tr> <tr> <td>4 Lateral lines</td> <td>9 Feedyard</td> <td>14 Abandoned water well</td> <td>.....</td> </tr> <tr> <td>5 Cess pool</td> <td>10 Livestock pens</td> <td>15 Oil well/Gas well</td> <td>.....</td> </tr> </table>									1 Septic tank	6 Seepage pit	11 Fuel storage	16 Other (specify below)	2 Sewer lines	7 Pit privy	12 Fertilizer storage	.....	3 Watertight sewer lines	8 Sewage lagoon	13 Insecticide storage	.....	4 Lateral lines	9 Feedyard	14 Abandoned water well	.....	5 Cess pool	10 Livestock pens	15 Oil well/Gas well	.....				
1 Septic tank	6 Seepage pit	11 Fuel storage	16 Other (specify below)																													
2 Sewer lines	7 Pit privy	12 Fertilizer storage	.....																													
3 Watertight sewer lines	8 Sewage lagoon	13 Insecticide storage	.....																													
4 Lateral lines	9 Feedyard	14 Abandoned water well	.....																													
5 Cess pool	10 Livestock pens	15 Oil well/Gas well	.....																													
Direction from well? ..... North How many feet? ..... 1900'																																
<table border="1"> <thead> <tr> <th>FROM</th> <th>TO</th> <th>PLUGGING MATERIALS</th> </tr> </thead> <tbody> <tr> <td>26.5</td> <td>1</td> <td>CEMENT Grout w/ 6% Bentonite</td> </tr> <tr> <td>1</td> <td>0</td> <td>Top seal</td> </tr> <tr> <td> </td> <td> </td> <td> </td> </tr> </tbody> </table>									FROM	TO	PLUGGING MATERIALS	26.5	1	CEMENT Grout w/ 6% Bentonite	1	0	Top seal															
FROM	TO	PLUGGING MATERIALS																														
26.5	1	CEMENT Grout w/ 6% Bentonite																														
1	0	Top seal																														

7	CONTRACTOR'S OF LANDOWNER'S CERTIFICATION: This water well was plugged under my jurisdiction and was completed on (mo/day/year) <u>10-15-02</u> and this record is true to the best of my knowledge and belief. Kansas Water Well Contractor's License No. <u>11-19-02</u> This Water Well Record was completed on (mo/day/year) <u>10-19-02</u> under the business name of <u>First K.E.E. Drilling Service Inc.</u> by (signature) <u>MLK</u>							
---	---	--	--	--	--	--	--	--

INSTRUCTIONS: Use typewriter or ball point pen. Please press firmly and print clearly. Please fill in blanks, underline or circle the correct answers. Send top three copies to Kansas Department of Health and Environment, Bureau of Water, Geology Section, 1000 SW Jackson St., Ste. 420, Topeka, Kansas 66612-1367. Telephone: 785/296-5522. Send one to Water Well Owner and retain one for your records.