

1 LOCATION OF WATER WELL: County: Butler	Fraction NW ¼ NW ¼ NE ¼	Section Number 16	Township Number T 26 S	Range Number R 3 E
--	-----------------------------------	-----------------------------	----------------------------------	------------------------------

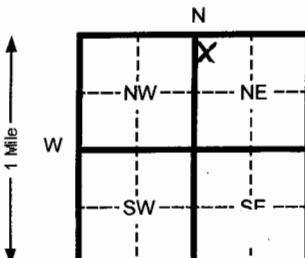
Distance and direction from nearest town or city street address of well if located within city?

850 Main Street, Benton, Kansas2 WATER WELL OWNER: **CB's Express**RR#, St. Address, Box #: **1320 SW Topeka Blvd**

Board of Agriculture, Division of Water Resources

City, State, ZIP Code: **Topeka, Ks 66612**

Application Number:

3 LOCATE WELL'S LOCATON WITH
AN "X" IN SECTION BOX:

4 DEPTH OF COMPLETED WELL	25.5	ft. ELEVATION:			
Depth(s) Groundwater Encountered	1 20	ft. 2	ft. 3	Ft.	
WELL'S STATIC WATER LEVEL	19.93	ft. below land surface measured on mo/day/yr	1-25-05		
Pump test data: Well water was		Ft. after	hours pumping	Gpm	
Est. Yield	Gpm: Well water was	Ft. after	Hours pumping	Gpm	
Bore Hole Diameter	8.625 in. to	25.5	Ft. and	in. to	Ft.
WELL WATER TO BE USED AS:	5 Public water supply	8 Air conditioning	11 Injection well		
1 Domestic 3 Feed lot 6 Oil field water supply	9 Dewatering	10 Monitoring well	12 Other (Specify below)		
2 Irrigation 4 Industrial 7 Lawn and garden (domestic)	MW-5				

Was a chemical/bacteriological sample submitted to Department? Yes No If yes, mo/day/yr sample was
Submitted Water Well Disinfected? Yes No

5 TYPE OF BLANK CASING USED:	5 Wrought Iron	8 Concrete tile	CASING JOINTS: Glued	Clamped
1 Steel	6 Asbestos-Cement	9 Other (specify below)	Welded	
2 PVC	7 Fiberglass		Threaded	<input checked="" type="checkbox"/> X

Blank casing diameter **2** in. to **25.5** Ft., Dia in. to ft., Dia in. to ft.

Casing height above land surface **FLUSH** in., weight SCH 40 Lbs./ft. Wall thickness or gauge No.

TYPE OF SCREEN OR PERFORATION MATERIAL:

1 Steel	3 Stainless steel	5 Fiberglass	8 RMP (SR)	10 Asbestos-cement
2 Brass	4 Galvanized steel	6 Concrete tile	9 ABS	11 Other (specify)
12 None used (open hole)				

SCREEN OR PERFORATION OPENINGS ARE:

1 Continuous slot	3 Mill slot	6 Wire wrapped	9 Drilled holes
2 Louvered shutter	4 Key punched	7 Torch cut	10 Other (specify)

SCREEN-PERFORATED INTERVALS: From **10.5** ft. to **25.5** ft. From ft. to ft.

SAND PACK INTERVALS: From **8.5** ft. to **25.5** ft. From ft. to ft.

6 GROUT MATERIAL: 1 Neat cement 2 Cement grout 3 Bentonite 4 Other

Grout Intervals From 3 **0** ft. to **6.5** Ft. From 2 **6.5** Ft. to **8.5** ft. From ft. to ft.

What is the nearest source of possible contamination:

1 Septic tank	4 Lateral lines	7 Pit privy	10 Livestock pens	14 Abandoned water well
2 Sewer lines	5 Cess pool	8 Sewage lagoon	11 Fuel storage	15 Oil well/ Gas well
3 Watertight sewer lines	6 Seepage pit	9 Feedyard	12 Fertilizer storage	16 Other (specify below)

Contaminated Site

Direction from well?

How many feet?

FROM	TO	CODE	LITHOLOGIC LOG	FROM	TO	PLUGGING INTERVALS
0	.75		Asphalt			
.75	18		Clay with silt (CL)			
18	18.25		Limestone stringer			
18.25	22.5		Mudstone			
22.5	23		Limestone stringer			
23	25.5		Mudstone, brown			
25.5	TD		End of Borehole			

7 CONTRACTOR'S OR LANDOWNER'S CERTIFICATION: This water well was (1) constructed, (2) reconstructed, or (3) plugged under my jurisdiction and was completed on (mo/day/yr) **01/04/05** And this record is true to the best of my knowledge and belief. Kansas

Water Well Contractor's License No. **585** This Water Well Record was completed on (mo/day/yr) **01/31/05**

under the business name of **Associated Environmental, Inc.** By (signature) **Darin R Duncan**

INSTRUCTIONS: Please fill in blanks and circle the correct answers. Send three copies to Kansas Department of Health and Environment, Bureau of Water, Topeka, Kansas 66620-0001. Telephone: 913-296-5545. Send one to WATER WELL OWNER and retain one for your records.