

1 LOCATION OF WATER WELL: County: Butler	Fraction NW 1/4 NW 1/4 NE 1/4	Section Number 16	Township Number T 26 S	Range Number R 3 E
--	---	-----------------------------	----------------------------------	------------------------------

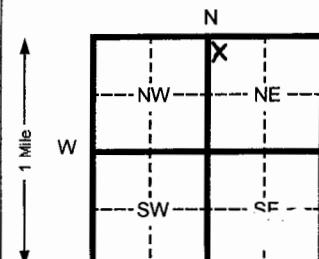
Distance and direction from nearest town or city street address of well if located within city?

850 Main Street, Benton, Kansas2 WATER WELL OWNER: **CB's Express**RR#, St. Address, Box #: **1320 SW Topeka Blvd**

Board of Agriculture, Division of Water Resources

City, State, ZIP Code: **Topeka, Ks 66612**

Application Number:

3 LOCATE WELL'S LOCATON WITH
AN "X" IN SECTION BOX:

4 DEPTH OF COMPLETED WELL

27 ft. ELEVATION:

Depth(s) Groundwater Encountered 1 ft. 2 ft. 3 ft.
WELL'S STATIC WATER LEVEL **20.83** ft. below land surface measured on mo/day/yr **1-25-05**Pump test data: Well water was
Est. Yield _____ Gpm: Well water was
Bore Hole Diameter **8.625** in. to

Ft. after hours pumping Gpm

Ft. after Hours pumping Gpm

WELL WATER TO BE USED AS: 5 Public water supply
1 Domestic 3 Feed lot 6 Oil field water supply
8 Air conditioning 11 Injection well2 Irrigation 4 Industrial 7 Lawn and garden (domestic) 10 Monitoring well
9 Dewatering 12 Other (Specify below) **MW-6**Was a chemical/bacteriological sample submitted to Department? Yes No If yes, mo/day/yr sample was
Submitted Water Well Disinfected? Yes No

5 TYPE OF BLANK CASING USED:

1 Steel 3 RMP (SR)
2 PVC 4 ABS

5 Wrought Iron 8 Concrete tile

CASING JOINTS: Glued _____ Clamped _____

6 Asbestos-Cement 9 Other (specify below)

Welded

7 Fiberglass

Threaded

Blank casing diameter **2** in. to **25.5** Ft., Dia in. to ft. in. to ft.Casing height above land surface **FLUSH** in., weight **SCH 40** Lbs./ft. Wall thickness or gauge No.

TYPE OF SCREEN OR PERFORATION MATERIAL:

7 PVC 10 Asbestos-cement

1 Steel 3 Stainless steel 5 Fiberglass 8 RMP (SR) 11 Other (specify)
2 Brass 4 Galvanized steel 6 Concrete tile 9 ABS 12 None used (open hole)

SCREEN OR PERFORATION OPENINGS ARE: 5 Gauzed wrapped 8 Saw cut 11 None (open hole)

1 Continuous slot 3 Mill slot 6 Wire wrapped 9 Drilled holes
2 Louvered shutter 4 Key punched 7 Torch cut 10 Other (specify)SCREEN-PERFORATED INTERVALS: From **12** ft. to **27** ft. From _____ ft. to _____ ft.

From _____ ft. to _____ ft. From _____ ft. to _____ ft.

SAND PACK INTERVALS: From **10** ft. to **27** ft. From _____ ft. to _____ ft.

From _____ ft. to _____ ft. From _____ ft. to _____ ft.

6 GROUT MATERIAL: 1 Neat cement 2 Cement grout 3 Bentonite 4 Other

Grout Intervals From **3** ft. to **8** ft. From **2** ft. to **8** ft. From **10** ft. to **10** ft. From _____ ft. to _____ ft.

What is the nearest source of possible contamination:

1 Septic tank 4 Lateral lines 7 Pit privy 10 Livestock pens 14 Abandoned water well
2 Sewer lines 5 Cess pool 8 Sewage lagoon 11 Fuel storage 15 Oil well/ Gas well
3 Watertight sewer lines 6 Seepage pit 9 Feedyard 12 Fertilizer storage 16 Other (specify below)
Contaminated Site

Direction from well?

How many feet?

FROM	TO	CODE	LITHOLOGIC LOG	FROM	TO	PLUGGING INTERVALS
0	11		Soil, clay with silt			
11	18.5		Mudstone, thinly laminated			
18.5	19		Limestone			
19	21.5		Mudstone			
21.5	23.5		Limestone			
23.5	27		Mudstone, brown			
27	TD		End of Borehole			

7 CONTRACTOR'S OR LANDOWNER'S CERTIFICATION: This water well was (1) constructed, (2) reconstructed, or (3) plugged under my jurisdiction and was completed on (mo/day/yr) **01/18/05**

And this record is true to the best of my knowledge and belief. Kansas

Water Well Contractor's License No. **585** This Water Well Record was completed on (mo/day/yr) **01/31/05**

under the business name of

Associated Environmental, Inc.By (signature) **Darin R Duncan**

INSTRUCTIONS: Please fill in blanks and circle the correct answers. Send three copies to Kansas Department of Health and Environment, Bureau of Water, Topeka, Kansas 66620-0001. Telephone: 913-296-5545. Send one to WATER WELL OWNER and retain one for your records.