

## 1 LOCATION OF WATER WELL:

Fraction

NE  $\frac{1}{4}$  NE  $\frac{1}{4}$  NW  $\frac{1}{4}$ 

Section Number

16

Township Number

T 26 S

Range Number

R 3 E

County: Butler

Distance and direction from nearest town or city street address of well if located within city?  
850 Main Street, Benton, Kansas

## 2 WATER WELL OWNER: CB's Express


RR#, St. Address, Box #: 1320 SW Topeka Blvd

Board of Agriculture, Division of Water Resources

City, State, ZIP Code: Topeka, Ks 66612

Application Number:

## 3 LOCATE WELL'S LOCATON WITH AN "X" IN SECTION BOX:

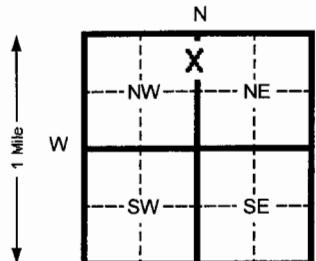

## 4 DEPTH OF COMPLETED WELL

25.5 ft. ELEVATION:

Depth(s) Groundwater Encountered 1 ft. 2 ft. 3 ft. Ft.

WELL'S STATIC WATER LEVEL 19.89 ft. below land surface measured on mo/day/yr 01/25/05

Pump test data: Well water was Ft. after hours pumping Gpm

Est. Yield Gpm: Well water was Ft. after Hours pumping Gpm

Bore Hole Diameter 8.625 in. to 25.5 Ft. and in. to Ft.

WELL WATER TO BE USED AS: 5 Public water supply 8 Air conditioning 11 Injection well

1 Domestic 3 Feed lot 6 Oil field water supply 9 Dewatering 12 Other (Specify below)

2 Irrigation 4 Industrial 7 Lawn and garden (domestic) 10 Monitoring well MW-7

Was a chemical/bacteriological sample submitted to Department? Yes No X If yes, mo/day/yr sample was

Submitted Water Well Disinfected? Yes No X

## 5 TYPE OF BLANK CASING USED:

5 Wrought Iron 8 Concrete tile Casing Joints: Glued Clamped

1 Steel 3 RMP (SR)

6 Asbestos-Cement 9 Other (specify below)

2 PVC 4 ABS

7 Fiberglass

Welded

X

Blank casing diameter 2 in. to 25.5 Ft., Dia in. to ft., Dia in. to ft.

Casing height above land surface FLUSH in., weight SCH 40 Lbs./ft. Wall thickness or gauge No.

TYPE OF SCREEN OR PERFORATION MATERIAL: 7 PVC 10 Asbestos-cement

1 Steel 3 Stainless steel 5 Fiberglass 8 RMP (SR) 11 Other (specify)

2 Brass 4 Galvanized steel 6 Concrete tile 9 ABS 12 None used (open hole)

SCREEN OR PERFORATION OPENINGS ARE: 5 Gauzed wrapped 8 Saw cut 11 None (open hole)

1 Continuous slot 3 Mill slot 6 Wire wrapped 9 Drilled holes

2 Louvered shutter 4 Key punched 7 Torch cut 10 Other (specify)

SCREEN-PERFORATED INTERVALS: From 15.5 ft. to 25.5 ft. From ft. to ft. From ft. to ft.

From ft. to ft. From ft. to ft. From ft. to ft.

SAND PACK INTERVALS: From 13.5 ft. to 25.5 ft. From ft. to ft. From ft. to ft.

From ft. to ft. From ft. to ft. From ft. to ft.

6 GROUT MATERIAL: 1 Neat cement 2 Cement grout 3 Bentonite 4 Other

Grout Intervals From 0 ft. to 11.5 Ft. From 2 ft. to 11.5 Ft. to 13.5 ft. From ft. to ft.

What is the nearest source of possible contamination: 10 Livestock pens 14 Abandoned water well

1 Septic tank 4 Lateral lines 7 Pit privy 11 Fuel storage 15 Oil well/ Gas well

2 Sewer lines 5 Cess pool 8 Sewage lagoon 12 Fertilizer storage 16 Other (specify below)

3 Watertight sewer lines 6 Seepage pit 9 Feedyard 13 Insecticide storage

Contaminated Site

Direction from well?

How many feet?

FROM	TO	CODE	LITHOLOGIC LOG	FROM	TO	PLUGGING INTERVALS
0	.25		Gravel			
.25	18.5		Clay with silt (CL)			
18.5	19		Limestone			
19	23		Mudstone			
23	23.5		Limestone			
23.5	25.5		Mudstone, brown			
25.5	TD		End of borehole			

## 7 CONTRACTOR'S OR LANDOWNER'S CERTIFICATION: This water well was (x) constructed, (2) reconstructed, or (3) plugged under my jurisdiction and w

Completed on (mo/day/yr) 01/19/05 And this record is true to the best of my knowledge and belief. Kansas

Water Well Contractor's License No. 585 This Water Well Record was completed on (mo/day/yr) 01/31/05

under the business name of Associated Environmental, Inc. By (signature) Darin R Duncan

INSTRUCTIONS: Please fill in blanks and circle the correct answers. Send three copies to Kansas Department of Health and Environment, Bureau of Water, Topeka, Kansas 66620-0001. Telephone: 913-296-5545. Send one to WATER WELL OWNER and retain one for your records.