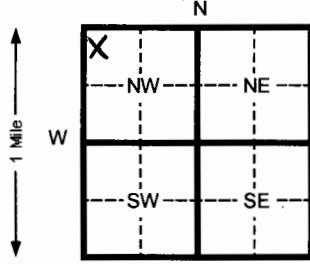
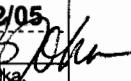


1 LOCATION OF WATER WELL: County: Butler	Fraction NW ¼ NW ¼ NW ¼	Section Number 16	Township Number T 26 S	Range Number R 3 E
Distance and direction from nearest town or city street address of well if located within city? 850 Main Street, Benton, Kansas				
2 WATER WELL OWNER: RR#, St. Address, Box # : 1320 SW Topeka Blvd	Board of Agriculture, Division of Water Resources City, State, ZIP Code : Topeka, Ks 66612			
3 LOCATE WELL'S LOCATON WITH AN "X" IN SECTION BOX:	4 DEPTH OF COMPLETED WELL 25.5 ft. ELEVATION: Depth(s) Groundwater Encountered 1 ft. 2 ft. 3 ft. Ft. WELL'S STATIC WATER LEVEL 22.30 ft. below land surface measured on mo/day/yr 06/29/05 Pump test data: Well water was Ft. after hours pumping Gpm Est. Yield Gpm: Well water was Ft. after Hours pumping Gpm Bore Hole Diameter 8.625 in. to 25.5 Ft. and in. to Ft. WELL WATER TO BE USED AS: 5 Public water supply 8 Air conditioning 11 Injection well 1 Domestic 3 Feed lot 6 Oil field water supply 9 Dewatering 12 Other (Specify below) 2 Irrigation 4 Industrial 7 Lawn and garden (domestic) 10 Monitoring well Mw-10			
 Was a chemical/bacteriological sample submitted to Department? Yes <input checked="" type="checkbox"/> No <input type="checkbox"/> If yes, mo/day/yr sample was Submitted Water Well Disinfected? Yes <input type="checkbox"/> No <input checked="" type="checkbox"/>				
5 TYPE OF BLANK CASING USED: 1 Steel <input type="checkbox"/> 3 RMP (SR) <input type="checkbox"/> 2 PVC <input checked="" type="checkbox"/> 4 ABS <input type="checkbox"/>	5 Wrought Iron <input type="checkbox"/> 8 Concrete tile <input type="checkbox"/> CASING JOINTS: Glued <input type="checkbox"/> Clamped <input type="checkbox"/> 6 Asbestos-Cement <input type="checkbox"/> 9 Other (specify below) <input type="checkbox"/> 7 Fiberglass <input type="checkbox"/> Ft., Dia in. to ft., Dia in. to ft.			
Blank casing diameter 2 in. to 15.5	FLUSH	in., weight	SCH 40	Lbs./ft. Wall thickness or gauge No.
6 TYPE OF SCREEN OR PERFORATION MATERIAL: 1 Steel <input type="checkbox"/> 3 Stainless steel <input type="checkbox"/> 5 Fiberglass <input type="checkbox"/> 8 RMP (SR) <input type="checkbox"/> 11 Other (specify) <input type="checkbox"/> 2 Brass <input type="checkbox"/> 4 Galvanized steel <input type="checkbox"/> 6 Concrete tile <input type="checkbox"/> 9 ABS <input type="checkbox"/> 12 None used (open hole) <input type="checkbox"/> SCREEN OR PERFORATION OPENINGS ARE: 1 Continuous slot <input type="checkbox"/> 3 Mill slot <input type="checkbox"/> 5 Gauzed wrapped <input type="checkbox"/> 8 Saw cut <input type="checkbox"/> 11 None (open hole) <input type="checkbox"/> 2 Louvered shutter <input type="checkbox"/> 4 Key punched <input type="checkbox"/> 6 Wire wrapped <input type="checkbox"/> 9 Drilled holes <input type="checkbox"/> 7 Torch cut <input type="checkbox"/> 10 Other (specify) <input type="checkbox"/>				
SCREEN-PERFORATED INTERVALS: From 15.5 ft. to 25.5 ft. From <input type="checkbox"/> ft. to <input type="checkbox"/> ft. SAND PACK INTERVALS: From 13.5 ft. to 25.5 ft. From <input type="checkbox"/> ft. to <input type="checkbox"/> ft.				

6 GROUT MATERIAL: 1 Neat cement <input type="checkbox"/> 2 Cement grout <input type="checkbox"/> 3 Bentonite <input checked="" type="checkbox"/> 4 Other <input type="checkbox"/> Grout Intervals From 3 0 ft. to 11.5 Ft. From 2 11.5 ft. to 13.5 ft. From <input type="checkbox"/> ft. to <input type="checkbox"/> ft.				
What is the nearest source of possible contamination: 1 Septic tank <input type="checkbox"/> 4 Lateral lines <input type="checkbox"/> 7 Pit privy <input type="checkbox"/> 10 Livestock pens <input type="checkbox"/> 14 Abandoned water well <input type="checkbox"/> 2 Sewer lines <input type="checkbox"/> 5 Cess pool <input type="checkbox"/> 8 Sewage lagoon <input type="checkbox"/> 11 Fuel storage <input type="checkbox"/> 15 Oil well/ Gas well <input type="checkbox"/> 3 Watertight sewer lines <input type="checkbox"/> 6 Seepage pit <input type="checkbox"/> 9 Feedyard <input type="checkbox"/> 12 Fertilizer storage <input type="checkbox"/> 16 Other (specify below) <input type="checkbox"/> Contaminated Site				
Direction from well?				
7 LITHOLOGIC LOG FROM TO CODE LITHOLOGIC LOG FROM TO PLUGGING INTERVALS 0 3 Silty Clay (CL) 3 19 Mudstone, weathered green-br 19 20 Limestone 20 22.5 Mudstone 22.5 25.5 Limestone 25.5 TD End of borehole				

7 CONTRACTOR'S OR LANDOWNER'S CERTIFICATION: This water well was (x) constructed, (2) reconstructed, or (3) plugged under my jurisdiction and w Completed on (mo/day/yr) 06/27/05 And this record is true to the best of my knowledge and belief. Kansas Water Well Contractor's License No. 585 This Water Well Record was completed on (mo/day/yr) 07/12/05 under the business name of Associated Environmental, Inc. By (signature) Bradley J. Johnson 
INSTRUCTIONS: Please fill in blanks and circle the correct answers. Send three copies to Kansas Department of Health and Environment, Bureau of Water, Topeka, Kansas 66620-0001. Telephone: 913-296-5545. Send one to WATER WELL OWNER and retain one for your records.'