

1 LOCATION OF WATER WELL:

Fraction

Section Number

Township Number

Range Number

County: ButlerNW $\frac{1}{4}$ SE $\frac{1}{4}$ NW $\frac{1}{4}$

21

T 26

S

R 3

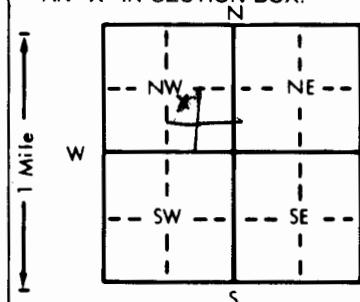
E/W

Distance and direction from nearest town or city street address of well if located within city? 1/2 mi. S of Benton2 WATER WELL OWNER: Tom FranklinRR#, St. Address, Box # : R1City, State, ZIP Code : Benton KS 67017

Board of Agriculture, Division of Water Resources

Application Number:

3 LOCATE WELL'S LOCATION WITH AN "X" IN SECTION BOX:

4 DEPTH OF COMPLETED WELL 62 ft. ELEVATION: slopeDepth(s) Groundwater Encountered 41 ft. 2. ft. 3. ft.WELL'S STATIC WATER LEVEL 23 ft. below land surface measured on mo/day/yr 9-26-81

Pump test data: Well water was ft. after hours pumping gpm

Est. Yield gpm: Well water was ft. after hours pumping gpm

Bore Hole Diameter 8 in. to 62 ft. and in. to ft.

WELL WATER TO BE USED AS: 5 Public water supply 8 Air conditioning 11 Injection well

1 Domestic 3 Feedlot 6 Oil field water supply 9 Dewatering 12 Other (Specify below)

2 Irrigation 4 Industrial 7 Lawn and garden only 10 Observation well

Was a chemical/bacteriological sample submitted to Department? Yes No X; If yes, mo/day/yr sample was submittedWater Well Disinfected? Yes X No

5 TYPE OF BLANK CASING USED:

1 Steel 3 RMP (SR)
2 PVC 4 ABS5 Wrought iron 8 Concrete tile CASING JOINTS: Glued X Clamped

6 Asbestos-Cement 9 Other (specify below) Welded

7 Fiberglass Threaded

Blank casing diameter 5 in. to 52 ft. Dia in. to ft. Dia in. to ft.Casing height above land surface 12 in. weight lbs./ft. Wall thickness or gauge No. 16016

TYPE OF SCREEN OR PERFORATION MATERIAL:

1 Steel 3 Stainless steel 5 Fiberglass 7 PVC 10 Asbestos-cement
2 Brass 4 Galvanized steel 6 Concrete tile 9 ABS 11 Other (specify)

SCREEN OR PERFORATION OPENINGS ARE:

5 Gauzed wrapped 8 Saw cut 11 None (open hole)
6 Wire wrapped 9 Drilled holes

7 Torch cut 10 Other (specify)

SCREEN-PERFORATED INTERVALS: From 42 ft. to 62 ft. From ft. to ft.

From ft. to ft. From ft. to ft.

GRAVEL PACK INTERVALS: From 62 ft. to 13 ft. From ft. to ft.

From ft. to ft. From ft. to ft.

6 GROUT MATERIAL: 1 Neat cement 2 Cement grout 3 Bentonite 4 Other

Grout Intervals: From 13 ft. to 3 ft. From ft. to ft. From ft. to ft.

What is the nearest source of possible contamination:

10 Livestock pens 14 Abandoned water well
11 Fuel storage 15 Oil well/Gas well
12 Fertilizer storage 16 Other (specify below)
13 Insecticide storage1 Septic tank 4 Lateral lines 7 Pit privy
2 Sewer lines 5 Cess pool 8 Sewage lagoon
3 Watertight sewer lines 6 Seepage pit 9 FeedyardDirection from well? S.W. How many feet? 110

FROM TO LITHOLOGIC LOG FROM TO LITHOLOGIC LOG

0	4	Clay gray brown	0	4	Clay gray brown
4	8	Clay yellow brown	4	8	Clay yellow brown
8	14	Limestone yellow	8	14	Limestone yellow
14	40	Shale yellow gray	14	40	Shale yellow gray
40	62	Shale gray	40	62	Shale gray

7 CONTRACTOR'S OR LANDOWNER'S CERTIFICATION: This water well was 1 constructed, (2) reconstructed, or (3) plugged under my jurisdiction and was completed on (mo/day/year) 9-21-81 and this record is true to the best of my knowledge and belief. KansasWater Well Contractor's License No. 363 This Water Well Record was completed on (mo/day/yr) 9-21-81 under the business name of Braddy Water Wells by (signature) Richard Braddy

INSTRUCTIONS: Use typewriter or ball point pen, PLEASE PRESS FIRMLY and PRINT clearly. Please fill in blanks, underline or circle the correct answers. Send top three copies to Kansas Department of Health and Environment, Division of Environment, Environmental Geology Section, Topeka, KS 66620. Send one to WATER WELL OWNER and retain one for your records.