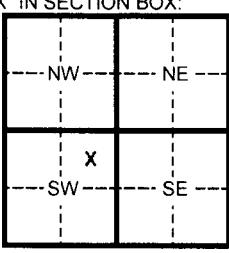
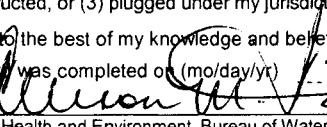


1 LOCATION OF WATER WELL:	Fraction County: Butler	NE $\frac{1}{4}$ NE $\frac{1}{4}$ SW $\frac{1}{4}$	Section Number 16	Township Number T 26 S	Range Number R 3 E				
Distance and direction from nearest town or city street address of well if located within city? 111 S. Main, Benton									
2 WATER WELL OWNER:	KDHE			Board of Agriculture, Division of Water Resources					
RR#, St. Address, Box #	1000 SW Jackson, Ste. 410			Application Number:					
City, State, ZIP Code	Topeka, KS 66612								
3 LOCATE WELL'S LOCATON WITH AN "X" IN SECTION BOX:									
4 DEPTH OF COMPLETED WELL	43.4 ft. ELEVATION: 1375.19 (TOC)								
Depth(s) Groundwater Encountered	1	Dry	ft. 2	ft. 3	ft.				
WELL'S STATIC WATER LEVEL	ft. below land surface measured on mo/day/yr								
Pump test data: Well water was	ft. after	hours pumping	gpm						
Est. Yield _____ gpm: Well water was	ft. after	hours pumping	gpm						
Bore Hole Diameter 8.5 in. to	43.4	ft. and	in. to	ft.					
WELL WATER TO BE USED AS:	5 Public water supply 1 Domestic 3 Feed lot 6 Oil field water supply 2 Irrigation 4 Industrial 7 Lawn and garden (domestic) 10 Monitoring well								
Was a chemical/bacteriological sample submitted to Department? Yes	No <input checked="" type="checkbox"/> If yes, mo/day/yr sample was submitted								
Water Well Disinfected? Yes	No <input checked="" type="checkbox"/>								
5 TYPE OF BLANK CASING USED:	1 Steel	3 RMP (SR)	5 Wrought Iron	8 Concrete tile	CASING JOINTS: Glued _____ Clamped _____				
	2 PVC	4 ABS	6 Asbestos-Cement	9 Other (specify below)	Welded				
Blank casing diameter	2	in. to	28	ft. Dia	in. to ft. Dia in. to ft.				
Casing height above land surface	Flushmount in., weight 0.703 lbs./ft. Wall thickness or gauge No. SCH. 40								
TYPE OF SCREEN OR PERFORATION MATERIAL:	7 PVC 10 Asbestos-cement 1 Steel 3 Stainless steel 5 Fiberglass 8 RMP (SR) 11 Other (specify) 2 Brass 4 Galvanized steel 6 Concrete tile 9 ABS 12 None used (open hole)								
SCREEN OR PERFORATION OPENINGS ARE:	5 Gauzed wrapped 8 Saw cut 11 None (open hole) 1 Continuous slot 3 Mill slot 6 Wire wrapped 9 Drilled holes 2 Louvered shutter 4 Key punched 7 Torch cut 10 Other (specify)								
SCREEN-PERFORATED INTERVALS:	From	28	ft. to	43.4	ft. From ft. to ft.				
GRAVEL PACK INTERVALS:	From	25	ft. to	43.4	ft. From ft. to ft.				
From	ft. to		ft. From	ft. to	ft.				
6 GROUT MATERIAL:	1 Neat cement	2 Cement grout	3 Bentonite	4 Other					
Grout Intervals	From 0.5	ft. to 25	ft. From	ft. to	ft. From ft. to ft.				
What is the nearest source of possible contamination:	10 Livestock pens 14 Abandoned water well 1 Septic tank 4 Lateral lines 7 Pit privy 11 Fuel storage 15 Oil well/ Gas well 2 Sewer lines 5 Cess pool 8 Sewage lagoon 12 Fertilizer storage 16 Other (specify below) 3 Watertight sewer lines 6 Seepage pit 9 Feedyard 13 Insecticide storage								
Direction from well?	How many feet?								
FROM	TO	CODE	LITHOLOGIC LOG		FROM	TO	PLUGGING INTERVALS		
0	0.3	Asphalt							
0.3	0.5	Gravel Fill							
0.5	21	Clay, dark brown to tan, with limestone lenses at 10.5 and 20 ft, with caliche nodules and gypsum							
21	43	Shale, olive, weathered, thin gypsum and limestone lenses							
43	43.4	Limestone							
7 CONTRACTOR'S OR LANDOWNER'S CERTIFICATION:	This water well was <input checked="" type="checkbox"/> (1) constructed, <input type="checkbox"/> (2) reconstructed, or <input type="checkbox"/> (3) plugged under my jurisdiction and was completed on (mo/day/yr) 09/25/07					and this record is true to the best of my knowledge and belief. Kansas			
Water Well Contractor's License No.						This Water Well Record was completed on (mo/day/yr) 10-3-07			
under the business name of	Geotechnical Services Inc.					by (signature) 			
INSTRUCTIONS:	Please fill in blanks and circle the correct answers. Send three copies to Kansas Department of Health and Environment, Bureau of Water, 1000 S W Jackson St, Ste. 420, Topeka, Kansas 66612-1367. Telephone: 913-296-5545. Send one to WATER WELL OWNER and retain one for your records.								