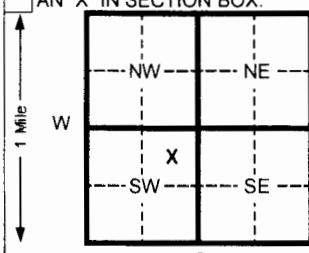
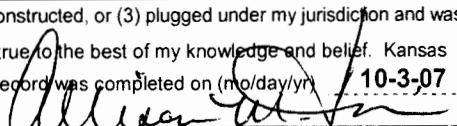


1 LOCATION OF WATER WELL:		Fraction	Section Number	Township Number	Range Number
County:	Butler	NE $\frac{1}{4}$ NE $\frac{1}{4}$ SW $\frac{1}{4}$	16	T 26 S	R 3 E
Distance and direction from nearest town or city street address of well if located within city? 103 S. Main, Benton					
2 WATER WELL OWNER: KDHE RR#, St. Address, Box # : 1000 SW Jackson, Ste. 410 City, State, ZIP Code : Topeka, KS 66612			Board of Agriculture, Division of Water Resources Application Number:		
3 LOCATE WELL'S LOCATON WITH AN "X" IN SECTION BOX:		4 DEPTH OF COMPLETED WELL 45 ft. ELEVATION: 1375.68 (TOC) Depth(s) Groundwater Encountered 1 44.1 ft. 2 ft. 3 ft. WELL'S STATIC WATER LEVEL ft. below land surface measured on mo/day/yr Pump test data: Well water was ft. after hours pumping gpm Est. Yield gpm: Well water was ft. after hours pumping gpm Bore Hole Diameter 8.5 in. to 45 ft. and in. to ft. WELL WATER TO BE USED AS: 5 Public water supply 8 Air conditioning 11 Injection well 1 Domestic 3 Feed lot 6 Oil field water supply 9 Dewatering 12 Other (Specify below) 2 Irrigation 4 Industrial 7 Lawn and garden (domestic) 10 Monitoring well			
		Was a chemical/bacteriological sample submitted to Department? Yes <input type="checkbox"/> No <input checked="" type="checkbox"/> If yes, mo/day/yr sample was submitted Water Well Disinfected? Yes <input type="checkbox"/> No <input checked="" type="checkbox"/>			
5 TYPE OF BLANK CASING USED: 1 Steel 3 RMP (SR) 5 Wrought Iron 8 Concrete tile CASING JOINTS: Glued _____ Clamped _____ 2 PVC 4 ABS 6 Asbestos-Cement 9 Other (specify below) Welded Blank casing diameter 2 in. to 30 ft. Dia in. to ft. Dia in. to ft. Casing height above land surface Flushmount in. weight 0.703 lbs./ft. Wall thickness or gauge No. SCH. 40					
6 TYPE OF SCREEN OR PERFORATION MATERIAL: 1 Steel 3 Stainless steel 5 Fiberglass 8 RMP (SR) 11 Other (specify) 2 Brass 4 Galvanized steel 6 Concrete tile 9 ABS 12 None used (open hole) SCREEN OR PERFORATION OPENINGS ARE: 1 Continuous slot 3 Mill slot 5 Gauzed wrapped 8 Saw cut 11 None (open hole) 2 Louvered shutter 4 Key punched 6 Wire wrapped 9 Drilled holes 10 Other (specify) SCREEN-PERFORATED INTERVALS: From 30 ft. to 45 ft. From ft. to ft. From ft. to ft. From ft. to ft. GRAVEL PACK INTERVALS: From 27 ft. to 45 ft. From ft. to ft. From ft. to ft. From ft. to ft.					
7 GROUT MATERIAL: 1 Neat cement 2 Cement grout 3 Bentonite 4 Other Grout Intervals From 0.5 ft. to 27 ft. From ft. to ft. From ft. to ft. What is the nearest source of possible contamination: 1 Septic tank 4 Lateral lines 7 Pit privy 10 Livestock pens 14 Abandoned water well 2 Sewer lines 5 Cess pool 8 Sewage lagoon 11 Fuel storage 15 Oil well/ Gas well 3 Watertight sewer lines 6 Seepage pit 9 Feedyard 12 Fertilizer storage 16 Other (specify below) 13 Insecticide storage Direction from well? How many feet?					
FROM	TO	CODE	LITHOLOGIC LOG	FROM	TO
0	0.5		Gravel Fill		
0.5	5		Clay, dark brown		
5	45		Shale, weathered, olive, thin limestone lenses and layers of crystalline calcite		
7 CONTRACTOR'S OR LANDOWNER'S CERTIFICATION: This water well was <input type="checkbox"/> (1) constructed, <input type="checkbox"/> (2) reconstructed, or <input type="checkbox"/> (3) plugged under my jurisdiction and was completed on (mo/day/yr) 09/25/07 and this record is true to the best of my knowledge and belief. Kansas Water Well Record was completed on (mo/day/yr) 10-3-07					
Water Well Contractor's License No. 531 by (signature)  under the business name of Geotechnical Services Inc.					
INSTRUCTIONS: Please fill in blanks and circle the correct answers. Send three copies to Kansas Department of Health and Environment, Bureau of Water, 1000 S W Jackson St., Ste. 420, Topeka, Kansas 66612-1367. Telephone: 913-296-5545. Send one to WATER WELL OWNER and retain one for your records.					