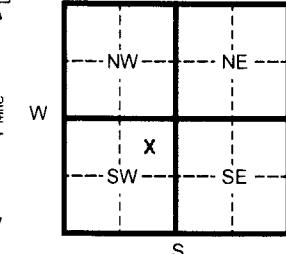
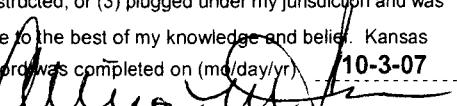


1 LOCATION OF WATER WELL:		Fraction County: <b>Butler</b>	NE $\frac{1}{4}$ NE $\frac{1}{4}$ SW $\frac{1}{4}$	Section Number 16	T 26 S	Range Number R 3 E
Distance and direction from nearest town or city street address of well if located within city? <b>121 S. Main, Benton</b>						
2 WATER WELL OWNER: <b>KDHE</b>						
RR#, St. Address, Box # : <b>1000 SW Jackson, Ste. 410</b>			Board of Agriculture, Division of Water Resources			
City, State, ZIP Code : <b>Topeka, KS 66612</b>			Application Number:			
3 LOCATE WELL'S LOCATON WITH AN "X" IN SECTION BOX:		4 DEPTH OF COMPLETED WELL <b>42</b> ft. ELEVATION: <b>1375.05 (TOC)</b>				
		Depth(s) Groundwater Encountered <b>1</b> <b>Dry</b> ft. 2 ft. 3 ft. WELL'S STATIC WATER LEVEL ft. below land surface measured on mo/day/yr Pump test data: Well water was ft. after hours pumping gpm Est. Yield gpm: Well water was ft. after hours pumping gpm Bore Hole Diameter <b>8.5</b> in. to <b>42</b> ft. and in. to ft. WELL WATER TO BE USED AS: 5 Public water supply 8 Air conditioning 11 Injection well 1 Domestic 3 Feed lot 6 Oil field water supply 9 Dewatering 12 Other (Specify below) 2 Irrigation 4 Industrial 7 Lawn and garden (domestic) <b>10 Monitoring well</b>				
		Was a chemical/bacteriological sample submitted to Department? Yes <b>No X</b> If yes, mo/day/yr sample was submitted Water Well Disinfected? Yes <b>No X</b>				
5 TYPE OF BLANK CASING USED:						
1 Steel		3 RMP (SR)		5 Wrought Iron	8 Concrete tile	CASING JOINTS: Glued _____ Clamped _____
<b>2 PVC</b>		4 ABS		6 Asbestos-Cement	9 Other (specify below)	Welded
Blank casing diameter <b>2</b> in. to <b>27</b> ft. Dia				7 Fiberglass		Threaded <b>Flush</b>
Casing height above land surface <b>Flushmount</b> in., weight <b>0.703</b>				lbs./ft. Wall thickness or gauge No. <b>SCH. 40</b>		
6 TYPE OF SCREEN OR PERFORATION MATERIAL:						
1 Steel		3 Stainless steel		5 Fiberglass	8 RMP (SR)	10 Asbestos-cement
2 Brass		4 Galvanized steel		6 Concrete tile	9 ABS	11 Other (specify)
SCREEN OR PERFORATION OPENINGS ARE:						
1 Continuous slot		<b>3 Mill slot</b>		5 Gauzed wrapped	8 Saw cut	11 None (open hole)
2 Louvered shutter		4 Key punched		6 Wire wrapped	9 Drilled holes	
SCREEN-PERFORATED INTERVALS:		From <b>27</b> ft. to <b>42</b> ft.		7 Torch cut	10 Other (specify)	
GRAVEL PACK INTERVALS:		From <b>25</b> ft. to <b>42</b> ft.		ft. From	ft. to	ft.
		From ft. to		ft. From	ft. to	ft.
		From ft. to		ft. From	ft. to	ft.
6 GROUT MATERIAL: 1 Neat cement 2 Cement grout <b>3 Bentonite</b> 4 Other						
Grout Intervals From <b>0.5</b> ft. to <b>25</b> ft. From				ft. to	ft. From	ft. to
What is the nearest source of possible contamination:						
1 Septic tank		4 Lateral lines		7 Pit privy	10 Livestock pens	14 Abandoned water well
2 Sewer lines		5 Cess pool		8 Sewage lagoon	11 Fuel storage	15 Oil well/ Gas well
3 Watertight sewer lines		6 Seepage pit		9 Feedyard	12 Fertilizer storage	16 Other (specify below)
Direction from well? How many feet?						
FROM	TO	CODE	LITHOLOGIC LOG		FROM	TO
<b>0</b>	<b>0.7</b>		<b>Gravel Fill</b>			
<b>0.7</b>	<b>14</b>		<b>Clay, dark brown to olive to blue gray, with limestone layers</b>			
<b>14</b>	<b>42</b>		<b>Shale, light olive to yellow brown, weathered, thin limestone and crystalline calcite layers</b>			
7 CONTRACTOR'S OR LANDOWNER'S CERTIFICATION: This water well was <b>(1) constructed, (2) reconstructed, or (3) plugged under my jurisdiction and was completed on (mo/day/yr) <b>09/25/07</b></b> and this record is true to the best of my knowledge and belief. Kansas Water Well Record was completed on (mo/day/yr) <b>10-3-07</b>						
Water Well Contractor's License No. <b>531</b>		This Water Well Record was completed on (mo/day/yr) <b>10-3-07</b>				
under the business name of <b>Geotechnical Services Inc.</b>		by (signature) 				
INSTRUCTIONS: Please fill in blanks and circle the correct answers. Send three copies to Kansas Department of Health and Environment, Bureau of Water, 1000 S W Jackson St., Ste. 420, Topeka, Kansas 66612-1367. Telephone: 913-296-5545. Send one to WATER WELL OWNER and retain one for your records.						