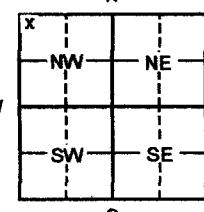
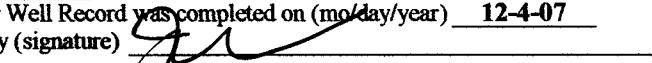


WATER WELL RECORD

Form WWC-5

Division of Water Resources, App. No. _____

1 LOCATION OF WATER WELL: Fraction County: Butler nw ¼ nw ¼ nw ¼			Section Number 5	Township Number T 26s S	Range Number R 3e E/W
Distance and direction from nearest town or city street address of well if located within city? 714 Corner Stone Ct			Global Positioning System (decimal degrees, min. of 4 digits) Latitude: _____ Longitude: _____ Elevation: _____ Datum: _____ Data Collection Method: _____		
2 WATER WELL OWNER: Jeff Michales Const RR#, St. Address, Box #: 13129 E Bridal Wood Ct City, State, ZIP Code: Wichita, Ks 67205					
3 LOCATE WELL'S LOCATON WITH AN "X" IN SECTION BOX:			4 DEPTH OF COMPLETED WELL 100 ft.		
			Depth(s) Groundwater Encountered 1 ft. 2 ft. 3 ft. WELL'S STATIC WATER LEVEL 35 ft. below land surface measured on mo/day/yr Pump test data: Well water was ft. after hours pumping gpm Est. Yield 20 gpm: Well water was ft. after hours pumping gpm WELL WATER TO BE USED AS: 5 Public water supply 8 Air conditioning 11 Injection well 1 Domestic 3 Feed lot 6 Oil field water supply 9 Dewatering 12 Other (Specify below) 2 Irrigation 4 Industrial 7 Domestic (lawn & garden) 10 Monitoring well		
			Was a chemical/bacteriological sample submitted to Department? Yes <input checked="" type="checkbox"/> No _____; If yes, mo/day/yr Sample was submitted Water Well Disinfected? Yes <input checked="" type="checkbox"/> No _____		
5 TYPE OF CASING USED:			CASING JOINTS: Glued <input checked="" type="checkbox"/> Clamped Welded _____ Threaded _____		
1 Steel 3 RMP (SR) 5 Wrought Iron 8 Concrete tile 2 PVC 4 ABS 6 Asbestos-Cement 9 Other (specify below)					
Blank casing diameter 5 in. to 60 ft., Dia			in. to ft., Dia in. to ft. ft.		
Casing height above land surface 12 in., Weight 2.40 lbs./ft.			Wall thickness or gauge No. 160psi		
TYPE OF SCREEN OR PERFORATION MATERIAL:					
1 Steel 3 Stainless steel 5 Fiberglass 7 PVC 9 ABS 11 Other (specify) 2 Brass 4 Galvanized steel 6 Concrete tile 8 RM (SR) 10 Asbestos-Cement 12 None used (open hole)					
SCREEN OR PERFORATION OPENINGS ARE:					
1 Continuous slot 3 Mill slot 5 Guaze wrapped 7 Torch cut 9 Drilled holes 11 None (open hole) 2 Louvered shutter 4 Key punched 6 Wire wrapped 8 Saw Cut 10 Other (specify)					
SCREEN-PERFORATED INTERVALS: From 60 ft. to 100 ft. From ft. to ft. ft.					
From ft. to ft. From ft. to ft. ft.					
GRAVEL PACK INTERVALS: From 35 ft. to 100 ft. From ft. to ft. ft.					
From ft. to ft. From ft. to ft. ft.					
6 GROUT MATERIAL: 1 Neat cement 2 Cement grout 3 Bentonite 4 Other					
Grout Intervals From 3 ft. to 35 ft. From ft. to ft. From ft. to ft. ft.					
What is the nearest source of possible contamination:					
1 Septic tank 4 Lateral lines 7 Pit privy 10 Livestock pens 13 Insecticide Storage 16 Other (specify below) 2 Sewer lines 5 Cess pool 8 Sewage lagoon 11 Fuel storage 14 Abandoned water well 3 Watertight sewer lines 6 Seepage pit 9 Feedyard 12 Fertilizer storage 15 Oil well/ gas well					
Direction from well? West How many feet? 12ft					
7 CONTRACTOR'S OR LANDOWNER'S CERTIFICATION: This water well was (1) constructed, (2) reconstructed, or (3) plugged under my jurisdiction and was completed on (mo/day/year) 11-28-07 and this record is true to the best of my knowledge and belief. Kansas Water Well Contractor's License No. 740. This Water Well Record was completed on (mo/day/year) 12-4-07 under the business name of Weninger Drilling inc. by (signature) 					

INSTRUCTIONS: Please fill in blanks or circle the correct answers. Send top three copies to Kansas Department of Health and Environment, Bureau of Water, Geology Section, 1000 SW Jackson St., Suite 420, Topeka, Kansas 66612-1367. Telephone 785-296-5522. Send one to WATER WELL OWNER and retain one for your records. Fee of \$5.00 for each constructed well. Visit us at <http://www.kdheks.gov/waterwell/>