


RR#, St. Address, Box # : 2 N. Nevada Ave.
City, State, ZIP Code : Colorado Springs, CO 80903

3 LOCATE WELL'S LOCATON WITH AN "X" IN SECTION BOX:

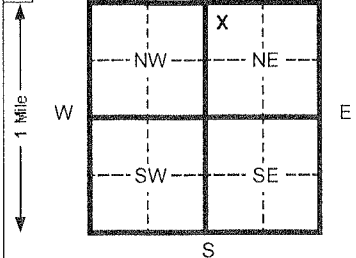

4 DEPTH OF COMPLETED WELL		15.0 ft. ELEVATION:		1318.38 (TOC)	
Depth(s) Groundwater Encountered	1	10.5	ft.	2	14.5 ft.
WELL'S STATIC WATER LEVEL		8.65		ft. below TOC measured on mo/day/yr	
Pump test data:		Well water was		ft. after	
				hours pumping	
Est. Yield		gpm:		ft. after	
				hours pumping	
Bore Hole Diameter	10.25	in. to	15.0	ft. and	
				in. to	
WELL WATER TO BE USED AS:		5 Public water supply	8 Air conditioning	11 Injection well	
1 Domestic	3 Feed lot	6 Oil field water supply	9 Dewatering	12 Other (Specify below)	
2 Irrigation	4 Industrial	7 Lawn and garden (domestic)	10 Monitoring well		
Was a chemical/bacteriological sample submitted to Department? Yes No <input checked="" type="checkbox"/> If yes, mo/day/yr sample was submitted					
Water Well Disinfected? Yes No <input checked="" type="checkbox"/>					

5 TYPE OF BLANK CASING USED: <div style="display: flex; justify-content: space-between;"> <div style="width: 45%;"> 1 Steel 2 PVC </div> <div style="width: 45%;"> 3 RMP (SR) 4 ABS </div> </div>	5 Wrought Iron 6 Asbestos-Cement 7 Fiberglass	8 Concrete tile 9 Other (specify below)	CASING JOINTS: Glued _____ Clamped _____ Welded _____ Threaded _____ Flush
---	---	--	--

Blank casing diameter	4	in. to	7.0	ft., Dia	in. to	ft., Dia	in. to	ft.
Casing height above land surface	0	in., weight	0.703	lbs./ft.	Wall thickness or gauge No.	SCH. 40		

TYPE OF SCREEN OR PERFORATION MATERIAL:				
1 Steel	3 Stainless steel	5 Fiberglass	7 PVC	10 Asbestos-cement
2 Brass	4 Galvanized steel	6 Concrete tile	8 RMP (SR)	11 Other (specify) _____
			9 ABS	12 None used (open hole)

SCREEN OR PERFORATION OPENINGS ARE:			
1 Continuous slot	3 Mill slot	5 Gauzed wrapped	8 Saw cut
2 Louvered shutter	4 Key punched	6 Wire wrapped	9 Drilled holes
		7 Torch cut	10 Other (specify)
			11 None (open hole)

SCREEN-PERFORATED INTERVALS:	From	7.0	ft. to	15.0	ft. From		ft. to		ft.
	From		ft. to		ft. From		ft. to		ft.
GRAVEL PACK INTERVALS:	From	6.5	ft. to	15.0	ft. From		ft. to		ft.
	From		ft. to		ft. From		ft. to		ft.

6	GROUT MATERIAL:		1 Neat cement	2 Cement grout	3 Bentonite	4 Other		
	Grout Intervals	From	1.0	ft to	6.5	ft From	ft to	ft

Great intervals from _____ to _____		to _____		to _____	
What is the nearest source of possible contamination:					
1 Septic tank	4 Lateral lines	7 Pit privy	10 Livestock pens	14 Abandoned water well	
2 Sewer lines	5 Cess pool	8 Sewage lagoon	11 Fuel storage	15 Oil well/ Gas well	
3 Watertight sewer lines	6 Seepage pit	9 Feedyard	12 Fertilizer storage	16 Other (specify below)	
			13 Insecticide storage		

Direction from well? _____ How many feet? _____

[illegible]

7 CONTRACTOR'S OR LANDOWNER'S CERTIFICATION: This water well was (1) constructed, (2) reconstructed, or (3) plugged under my jurisdiction and was completed on (mo/day/yr) 07/12/11 and this record is true to the best of my knowledge and belief. Kansas Water Well Contractor's License No. 531 This Water Well Record was completed on (mo/day/yr) 07/22/11 under the business name of Geotechnical Services Inc. by (signature) [Signature]

INSTRUCTIONS: Please fill in blanks and circle the correct answers. Send three copies to Kansas Department of Health and Environment, Bureau of Water, 1000 S W Jackson St., Ste. 420, Topeka, Kansas 66612-1367. Telephone: 913-296-5545. Send one to WATER WELL OWNER and retain one for your records.