

1 LOCATION OF WATER WELL:	FRACTION	Section Number	Township Number	Range Number
Butler	NW 1/4 NW 1/4 SW 1/4	3	26 S	R 3E E/W

Distance and direction from nearest town or city street address of well if located within city?

1/2 m. E. of Benton, 1 1/2 N. of Hwy 254, 1/8 E. Benton, Kansas

2 WATER WELL OWNER: NELSON, Mark


RR#, ST. ADDRESS, BOX #: RR #1

CITY, STATE, ZIP CODE: Benton, Kansas

Board of Agriculture, Division of Water Resource

Application Number:

3 LOCATE WELL'S LOCATION WITH AN "X" IN SECTION BOX:

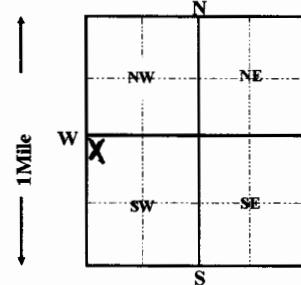

4 DEPTH OF COMPLETED WELL 95 ft. ELEVATION:

Depth(s) groundwater Encountered	1	ft.	2	ft.	3	ft.
----------------------------------	---	-----	---	-----	---	-----

WELL'S STATIC WATER LEVEL 20 FT. BELOW LAND SURFACE MEASURED ON mo/day/yr

10/28/1992

Pump test data: Well water was ft. after hours pumping gpm

Est. Yield gpm: Well water was ft. after hours pumping gpm

Bore Hole Diameter 12 in. to 95 ft., and in. to ft.

WELL WATER TO BE USED AS: 5 Public water supply 8 Air conditioning 11 Injection well

1 Domestic 3 Feedlot 6 Oil field water supply 9 Dewatering 12 Other (Specify below)

2 Irrigation 4 Industrial 7 Lawn and garden only 10 Monitoring well

Was a chemical/bacteriological sample submitted to Department? Yes No ; If yes, mo/day/yr sample was submitted

Water Well Disinfected? Yes No

5 TYPE OF CASING USED:

1 Steel 3 RMP (SR)

2 PVC 4 ABS

5 Wrought iron 8 Concrete tile

6 Asbestos-Cement 9 Other (Specify below)

7 Fiberglass SDR-26

CASING JOINTS: Glued Clamped

Welded

Threaded

Blank casing Diameter 5 in. to 19 ft., Dia

in. to weight

ft., Dia in. to ft.

Wall thickness or gauge No. .214

Casing height above land surface 12 in., weight

10 Asbestos-cement

TYPE OF SCREEN OR PERFORATION MATERIAL:

1 Steel 3 Stainless Steel

5 Fiberglass

8 RMP (SR)

11 other (specify)

2 Brass 4 Galvanized steel

6 Concrete tile

9 ABS

12 None used (open hole)

SCREEN OR PERFORATION OPENING ARE:

1 Continous slot 3 Mill slot

5 Gauzed wrapped

6 Wire wrapped

8 Saw cut

11 None (open hole)

2 Louvered shutter 4 Key punched

7 Torch cut

9 Drilled holes

10 Other (specify)

SCREEN-PERFORATION INTERVALS:

from 19

ft. to 95

ft., From

ft. to

ft.

from

ft. to

ft., From

ft. to

ft.

GRAVEL PACK INTERVALS:

from 20

ft. to 95

ft., From

ft. to

ft.

from

ft. to

ft., From

ft. to

ft.

6 GROUT MATERIAL: 1 Neat cement

2 Cement grout

3 Bentonite

4 Other

Grout Intervals: From 4 ft. to 19

ft., From

ft. to

ft., From

ft. to

ft.

What is the nearest source of possible contamination:

1 Septic tank 4 Lateral lines

7 Pit privy

10 Livestock pens

14 Abandon water well

2 Sewer lines 5 Cess pool

8 Sewage lagoon

11 Fuel storage

15 Oil well/Gas well

3 Watertight sewer lines 6 Seepage pit

9 Feedyard

12 Fertilizer storage

16 Other (specify below)

13 Insecticide storage

Direction from well? North

How many feet? 125

FROM TO LITHOLOGIC LOG

FROM TO PLUGGING INTERVALS

0 3 topsoil

3 21 brown shale

21 95 grey shale

7 CONTRACTOR'S OR LANDOWNER'S CERTIFICATION: This water well was (1) constructed, (2) reconstructed, or (3) plugged under my jurisdiction and was completed on (mo/day/year) 10/28/1992 and this record is true to the best of my knowledge and belief. Kansas Water

Well Contractor's License No. 236 This Water Well Record was completed on (mo/day/yr) 12/11/92

Under the business name of Harp Well & Pump Service, Inc. by (signature)

Jane Frederick