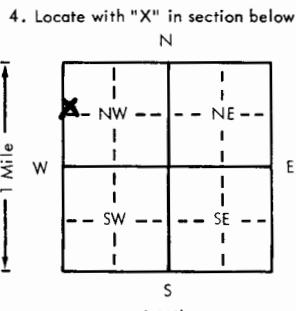
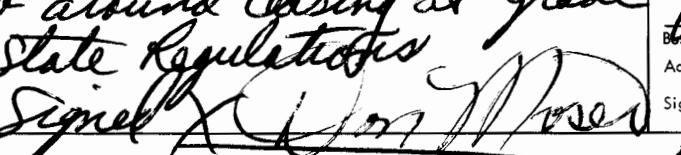
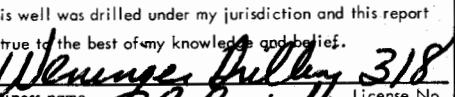
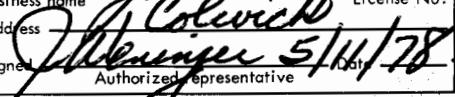
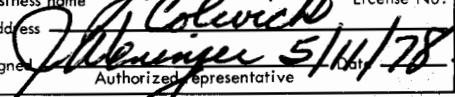


Location of well:	County	Fraction	Section number	Township number	Range number	
Butler		SW 1/4 NW 1/4 NW 1/4	11	T 26 S R	30	
1. Distance and direction from nearest town or city: 1 1/2 E 1 1/4 S. Benton Ks			3. Owner of well: R.R. or street: City, state, zip code: Donald R. MOSER Benton Ks 67017			
4. Locate with "X" in section below: 			Sketch no - Well 			
5. Type and color of material			From	To		
Top soil.			0	3		
Gray clay.			3	21		
Charcoal shale			21	75		
Mica			75	82		
Charcoal shale			82	105		
Mica			105	109		
Charcoal shale			109	125		
(Use a second sheet if needed)						
18. Elevation:	19. Remarks: Customers to furnish 4x4x4" slab around casing at grade per State Regulations Signed 					20. Water well contractor's certification: This well was drilled under my jurisdiction and this report is true to the best of my knowledge and belief. Weninger, Colwick 318 Business name:  Address:  Signed  Authorized representative
Topography: Hill Slope Upland Valley						