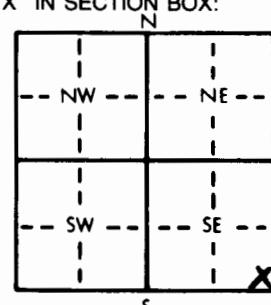


1 LOCATION OF WATER WELL: County: BELL	Fraction: SE 1/4 SE 1/4 SE 1/4	Section Number: 11	Township Number: T 26 S	Range Number: R 30 E	
Distance and direction from nearest town or city, street address of well if located within city? 2 miles East Benton KS.					
2 WATER WELL OWNER: RR#, St. Address, Box # : City, State, ZIP Code :	DICK Gould 7032 10 Clarence Wichita KS 67212				Board of Agriculture, Division of Water Resources Application Number:
3 LOCATE WELL'S LOCATION WITH AN "X" IN SECTION BOX: 	4 DEPTH OF COMPLETED WELL: 72 ft. ELEVATION: 30 Depth(s) Groundwater Encountered: 1 30 ft. 2. 30 ft. 3. 72484 ft. WELL'S STATIC WATER LEVEL: 30 ft. below land surface measured on mo/day/yr Pump test data: Well water was 90 ft. after 10 hours pumping 10 gpm Est. Yield: 8 gpm: Well water was 90 ft. after 10 hours pumping 10 gpm Bore Hole Diameter: 11 in. to 72 ft., and 10 in. to ft. WELL WATER TO BE USED AS: 1 Domestic 3 Feedlot 6 Oil field water supply 8 Air conditioning 11 Injection well 2 Irrigation 4 Industrial 7 Lawn and garden only 10 Observation well 12 Other (Specify below) Was a chemical/bacteriological sample submitted to Department? Yes <input checked="" type="checkbox"/> No <input type="checkbox"/> If yes, mo/day/yr sample was submitted Water Well Disinfected? Yes <input checked="" type="checkbox"/> No <input type="checkbox"/>				
5 TYPE OF BLANK CASING USED: 1 Steel 3 RMP (SB) 2 PVC 4 ABS	5 Wrought iron 6 Asbestos-Cement 7 Fiberglass	8 Concrete tile 9 Other (specify below)	CASING JOINTS: Glued <input checked="" type="checkbox"/> Clamped <input type="checkbox"/> Welded <input type="checkbox"/> Threaded <input type="checkbox"/>		
Blank casing diameter: 5 in. to 20 ft., Dia 1.59 in. to ft. , Dia in. to ft.	lbs./ft. Wall thickness or gauge No. SDR-26				
Casing height above land surface: 12 in., weight 1.59 lbs./ft. Wall thickness or gauge No. SDR-26					
TYPE OF SCREEN OR PERFORATION MATERIAL: 1 Steel 3 Stainless steel 5 Fiberglass 7 PVC 10 Asbestos-cement 2 Brass 4 Galvanized steel 6 Concrete tile 8 RMP (SR) 11 Other (specify) 2 Louvered shutter 4 Key punched 7 Gauzed wrapped 9 ABS 12 None used (open hole) 3 Mill slot					
SCREEN OR PERFORATION OPENINGS ARE: 1 Continuous slot 3 Mill slot 5 Gauzed wrapped 8 Saw cut 11 None (open hole) 2 Louvered shutter 4 Key punched 6 Wire wrapped 9 Drilled holes From 20 ft. to 72 ft., From ft. to ft. , From ft. to ft. , From ft. to ft. , From ft. to ft.					
SCREEN-PERFORATED INTERVALS: From 20 ft. to 72 ft., From ft. to ft. , From ft. to ft. , From ft. to ft.					
GRAVEL PACK INTERVALS: From 13 ft. to 72 ft., From ft. to ft. , From ft. to ft.					
6 GROUT MATERIAL: Grout Intervals: From 3 ft. to 13 ft., From ft. to ft. , From ft. to ft. , From ft. to ft.	1 Neat cement 2 Cement grout	3 Bentonite 4 Other	10 Livestock pens 11 Fuel storage 12 Fertilizer storage 13 Insecticide storage How many feet? 80		
What is the nearest source of possible contamination: 1 Septic tank 2 Sewer lines 3 Watertight sewer lines 4 Lateral lines 5 Cess pool 6 Seepage pit	7 Pit privy 8 Sewage lagoon 9 Feedyard	14 Abandoned water well 15 Oil well/Gas well 16 Other (specify below)			
Direction from well? SE					
FROM	TO	LITHOLOGIC LOG	FROM	TO	LITHOLOGIC LOG
0	2	Top soil.			
2	25	Clay.			
25	72	Charcoal shale.			

7 CONTRACTOR'S OR LANDOWNER'S CERTIFICATION: This water well was (1) constructed, (2) reconstructed, or (3) plugged under my jurisdiction and was completed on (mo/day/year) 7-3-4-84 and this record is true to the best of my knowledge and belief. Kansas
Water Well Contractor's License No. 318 This Water Well Record was completed on (mo/day/yr) 7-2-4-84 by (signature) James Ellingson
under the business name of James Ellingson
INSTRUCTIONS: Use typewriter or ball point pen. PLEASE PRESS FIRMLY and PRINT clearly. Please fill in blanks, underline or circle the correct answers. Send top three copies to Kansas Department of Health and Environment, Division of Environment, Environmental Geology Section, Topeka, KS 66620. Send one to WATER WELL OWNER and retain one for your records.