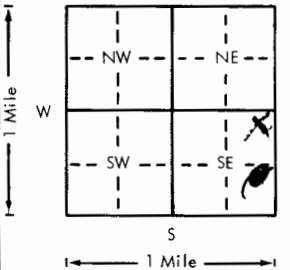
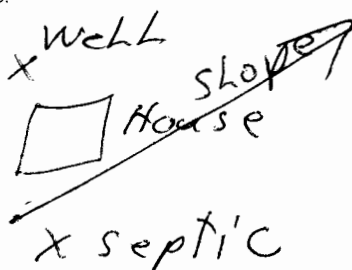


USE TYPEWRITER OR BALL  
POINT PEN-PRESS FIRMLY,  
PRINT CLEARLY.

WATER WELL RECORD  
KSA 82a-1201-1215

Kansas Department of Health and  
Environment-Division of Environment  
(Water well Contractors)  
Topeka, Kansas 66620

1. Location of well:		County <b>Butler</b>	Fraction <b>NE 1/4 NE 1/4 SE 1/4</b>	Section number <b>12</b>	Township number <b>T 26 S</b>	Range number <b>R 3 E/W</b>
2. Distance and direction from nearest town or city: <b>2 W</b> <b>1 N Towanda</b>		3. Owner of well: <b>Fred Colwell</b> <b>125 WILSON</b> City, state, zip code: <b>Towanda, KS 66666</b>		6. Bore hole dia. <b>8</b> in. Completion date <b>7/28/79</b> Well depth <b>100</b> ft.		
* Locate with "X" in section below: 		Sketch map: 		7. <input checked="" type="checkbox"/> Cable tool <input type="checkbox"/> Rotary <input type="checkbox"/> Driven <input type="checkbox"/> Dug <input type="checkbox"/> Hollow rod <input type="checkbox"/> Jetted <input type="checkbox"/> Bored <input type="checkbox"/> Reverse rotary		
5. Type and color of material		From		To		8. Use: <input checked="" type="checkbox"/> Domestic <input type="checkbox"/> Public supply <input type="checkbox"/> Industry <input type="checkbox"/> Irrigation <input type="checkbox"/> Air conditioning <input type="checkbox"/> Stock <input type="checkbox"/> Lawn <input type="checkbox"/> Oil field water <input type="checkbox"/> Other
Top Soil		0		3		9. Casing: Material <b>Plas</b> Height: Above or below Threaded <input type="checkbox"/> Welded <input checked="" type="checkbox"/> Surface <b>18</b> in. RMP <input checked="" type="checkbox"/> PVC Weight <b>100</b> lbs./ft. Dia. <b>3</b> in. to <b>100</b> ft. depth Wall Thickness: inches or Dia. <input type="checkbox"/> in. to <input type="checkbox"/> ft. depth gage No. <b>175</b>
Clay Red		3		10		10. Screen: Manufacturer's name <b>San Flower</b> Type <b>100</b> Dia. <b>5</b> Slot/gauze <b>1/16</b> Length <b>20'</b> Set between <b>60</b> ft. and <b>80</b> ft. ft. and <input type="checkbox"/> ft.
Yellow Clay & Rock		10		25		Gravel pack? <b>Yes</b> Size range of material <b>3/8</b>
Shale		25		40		11. Static water level: <b>50</b> ft. below land surface Date <input type="checkbox"/>
Lime & Shale		40		50		12. Pumping level below land surfaces: <b>55</b> ft. after <b>1</b> hrs. pumping <b>50</b> g.p.m. ft. after <input type="checkbox"/> hrs. pumping <input type="checkbox"/> g.p.m. Estimated maximum yield <b>50</b> g.p.m.
Sandy Lime		50		70		13. Water sample submitted: <input checked="" type="checkbox"/> Yes <input type="checkbox"/> No Date <input type="checkbox"/>
Lime		70		80		14. Well head completion: <input type="checkbox"/> Pitless adapter <input type="checkbox"/> Inches above grade
Shale		80		100		15. Well grouted? <b>Yes</b> With: <input checked="" type="checkbox"/> Neat cement <input type="checkbox"/> Bentonite <input type="checkbox"/> Concrete Depth: From <b>0</b> ft. to <b>10</b> ft.
(Use a second sheet if needed)						16. Nearest source of possible contamination: ft. <b>100</b> Direction <b>NE</b> Type <b>Septic</b> Well disinfected upon completion? <input checked="" type="checkbox"/> Yes <input type="checkbox"/> No
						17. Pump: <input checked="" type="checkbox"/> Not installed Manufacturer's name <input type="checkbox"/> Model number <input type="checkbox"/> HP <input type="checkbox"/> Volts <input type="checkbox"/> Length of drop pipe <input type="checkbox"/> ft. capacity <input type="checkbox"/> g.p.m. Type: <input type="checkbox"/> Submersible <input type="checkbox"/> Turbine <input type="checkbox"/> Jet <input type="checkbox"/> Reciprocating <input type="checkbox"/> Centrifugal <input type="checkbox"/> Other
18. Elevation:		19. Remarks: <b>Owner to install Cement Slab around Well Head</b>		20. Water well contractor's certification: This well was drilled under my jurisdiction and this report is true to the best of my knowledge and belief. <b>Winter Well Drill 251</b> Business name <b>P2 Box 30 Augusta</b> License No. <b>1/4 NE 1/4 NE 1/4</b> Address <b>3/11/79</b> Date <b>3/11/79</b> Signed <b>Charles Winter</b> Authorized representative		