


1 LOCATION OF WATER WELL: County: <u>Butler</u>	Fraction <u>SW</u> $\frac{1}{4}$ <u>SW</u> $\frac{1}{4}$ <u>NE</u> $\frac{1}{4}$	Section Number <u>14</u>	Township Number T <u>36</u> S	Range Number R <u>3</u> <u>EW</u>
--	---	-----------------------------	----------------------------------	--------------------------------------

Distance and direction from nearest town or city street address of well if located within city?
1 1/2 miles East of Benton, 1/2 South, East side

2 WATER WELL OWNER: **SKIP FOLEY**
RR#, St. Address, Box # : **ROUTE 1**
City, State, ZIP Code : **BENTON, KANSAS 67017**

Board of Agriculture, Division of Water Resources
Application Number:

LOCATE WELL'S LOCATION WITH AN "X" IN SECTION BOX: N 4. DEPTH OF COMPLETED WELL: 90 ft. ELEVATION: 84
Depth(s) Groundwater Encountered 1. 84 ft. 2. _____ ft. 3. _____ ft.

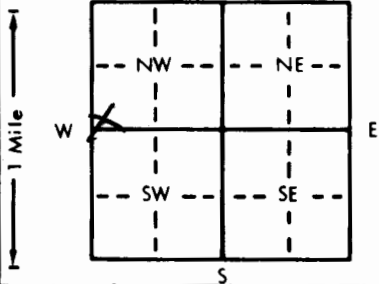

4 DEPTH OF COMPLETED WELL 40 ft. ELEVATION: _____
 Depth(s) Groundwater Encountered 1. 20 ft. 2. 86 ft. 3. _____ ft.
 WELL'S STATIC WATER LEVEL 20 ft. below land surface measured on mo/day/yr _____
 Pump test data: Well water was _____ ft. after _____ hours pumping _____ gpm
 Est. Yield 40 gpm: Well water was _____ ft. after _____ hours pumping _____ gpm
 Bore Hole Diameter 8 in. to _____ ft., and _____ in. to _____ ft.
 WELL WATER TO BE USED AS:
 1 Domestic 3 Feedlot 6 Oil field water supply 8 Air conditioning 11 Injection well
 2 Irrigation 4 Industrial 7 Lawn and garden only 9 Dewatering 12 Other (Specify below) _____
 Was a chemical/bacteriological sample submitted to Department? Yes _____ No _____ If yes, mo/day/yr sample was submitted _____
 Water Well Disinfected? Yes _____ No _____

5	TYPE OF BLANK CASING USED:	5 Wrought iron	8 Concrete tile	CASING JOINTS	Glued	Clamped
	1 Steel	3 RMP (SR)	6 Asbestos-Cement		Welded	
	2 PVC	4 ABS	7 Fiberglass		Threaded	
			9 Other (specify below)			

Blank casing diameter 5 in. to ft., Dia. in. to ft., Dia. in. to ft.
Casing height above land surface 18 in., weight 160 lbs./ft. Wall thickness or gauge No.

TYPE OF SCREEN OR PERFORATION MATERIAL:

1 Steel	3 Stainless steel	5 Fiberglass	7 PVC	10 Asbestos-cement
2 Brass	4 Galvanized steel	6 Concrete tile	8 RMP (SR)	11 Other (specify)
			9 ABS	12 None used (open hole)

SCREEN OR PERFORATION OPENINGS ARE:

1 Continuous slot	3 Mill slot	5 Gauzed wrapped	8 Saw cut	11 None (open hole)
2 Louvered shutter	4 Key punched	6 Wire wrapped	9 Drilled holes	
		7 Torch cut	10 Other (specify)	

SCREEN-PERFORATED INTERVALS:	From 10 ft. to 10 ft.,	From ft. to ft.
	From ft. to ft.,	From ft. to ft.
GRAVEL PACK INTERVALS:	From 20 ft. to 90 ft.,	From ft. to ft.
	From ft. to ft.,	From ft. to ft.

6 GROUT MATERIAL: 1 Neat cement 2 Cement grout 3 Bentonite 4 Other
Grout Intervals: From 3 ft. to 20 ft., From ft. to ft., From ft. to ft.

What is the nearest source of possible contamination:

1 Septic tank	4 Lateral lines	7 Pit privy	10 Livestock pens	14 Abandoned water well
2 Sewer lines	5 Cess pool	8 Sewage lagoon	11 Fuel storage	15 Oil well/Gas well
3 Watertight sewer lines	6 Seepage pit	9 Feedyard	12 Fertilizer storage	16 Other (specify below)
			13 Insecticide storage

Direction from well? _____ How many feet? 100

FROM	TO	LITHOLOGIC LOG	FROM	TO	LITHOLOGIC LOG
0	8	Earth			
8	12	hard Limestone			
12	19	Red Bed			
19	56	Gray Clay			
56	62	Red Bed			
62	74	Gray Shale			
74	80	Red Bed			
80	90	Gray Shale lime			

7 CONTRACTOR'S OR LANDOWNER'S CERTIFICATION: This water well was (1) constructed, (2) reconstructed, or (3) plugged under my jurisdiction and was completed on (mo/day/year) May 29, 1984 and this record is true to the best of my knowledge and belief. Kansas Water Well Contractor's License No. 424 This Water Well Record was completed on (mo/day/yr) June 12, 1984 under the business name of Reisner Well Drilling by (signature) Jeffrey Reisner

INSTRUCTIONS: Use typewriter or ball point pen. PLEASE PRESS FIRM and PRINT clearly. Please fill in blanks, underline or circle the correct answers. Send to:

three copies to Kansas Department of Health and Environment, Division of Environment, Environmental Geology Section, Topeka, KS 66620. Send one to WATER WELL OWNER and retain one for your records.