

WATER WELL RECORD

Form WWC-5

KSA 82a-1212

1 LOCATION OF WATER WELL:

Fraction

1/4 N/W 1/4 N/W 1/4

Section Number

15

Township Number

T 26 S

Range Number

R 3

E/W

County: BUTLER Distance and direction from nearest town or city street address of well, if located within city?

470' EAST & 100' SOUTH OF N/W CORNER SECTION 15

2 WATER WELL OWNER: CITY OF BENTON KANSAS


Board of Agriculture, Division of Water Resources

RR#, St. Address, Box # : CITY HALL

Application Number:

City, State, ZIP Code : BENTON, KS 67017

3 LOCATE WELL'S LOCATION WITH AN "X" IN SECTION BOX:

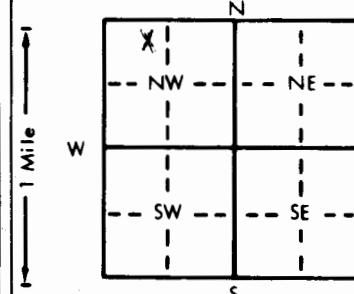

4 DEPTH OF COMPLETED WELL ft. ELEVATION:

Depth(s) Groundwater Encountered 1. ft. 2. ft. 3. ft.

WELL'S STATIC WATER LEVEL ft. below land surface measured on mo/day/yr 8-18-82

Pump test data: Well water was ft. after hours pumping gpm

Est. Yield gpm: Well water was ft. after hours pumping gpm

Bore Hole Diameter in. to ft., and in. to ft.

WELL WATER TO BE USED AS: 5 Public water supply 8 Air conditioning 11 Injection well

1 Domestic 3 Feedlot 6 Oil field water supply 9 Dewatering 12 Other (Specify below)

2 Irrigation 4 Industrial 7 Lawn and garden only 10 Observation well

Was a chemical/bacteriological sample submitted to Department? Yes. No. If yes, mo/day/yr sample was submitted

Water Well Disinfected? Yes No

5 TYPE OF BLANK CASING USED:

1 Steel 3 RMP (SR)
2 PVC 4 ABS

5 Wrought iron 8 Concrete tile Casing Joints: Glued Clamped

6 Asbestos-Cement 9 Other (specify below) Welded

7 Fiberglass Threaded

Blank casing diameter 12" in. to ft., Dia in. to ft., Dia in. to ft.

Casing height above land surface 1357 in., weight lbs./ft. Wall thickness or gauge No.

TYPE OF SCREEN OR PERFORATION MATERIAL:

1 Steel 3 Stainless steel 5 Fiberglass 7 PVC 10 Asbestos-cement
2 Brass 4 Galvanized steel 6 Concrete tile 9 ABS 11 Other (specify)
12 None used (open hole)

SCREEN OR PERFORATION OPENINGS ARE:

1 Continuous slot 3 Mill slot 5 Gauzed wrapped 8 Saw cut 11 None (open hole)
2 Louvered shutter 4 Key punched 6 Wire wrapped 9 Drilled holes
7 Torch cut 10 Other (specify)

SCREEN-PERFORATED INTERVALS: From. ft. to ft., From. ft. to ft.

From. ft. to ft., From. ft. to ft.

GRAVEL PACK INTERVALS: From. ft. to ft., From. ft. to ft., From. ft. to ft.

6 GROUT MATERIAL: 1 Neat cement 2 Cement grout 3 Bentonite 4 Other INORGANIC Clays

Grout Intervals: From. ft. to ft., From. ft. to ft., From. ft. to ft.

What is the nearest source of possible contamination:

1 Septic tank 4 Lateral lines 7 Pit privy 10 Livestock pens 14 Abandoned water well
2 Sewer lines 5 Cess pool 8 Sewage lagoon 11 Fuel storage 15 Oil well/Gas well
3 Watertight sewer lines 6 Seepage pit 9 Feedyard 12 Fertilizer storage 16 Other (specify below)
13 Insecticide storageDirection from well? SOUTHHow many feet? 35'

FROM TO LITHOLOGIC LOG FROM TO LITHOLOGIC LOG

40 8 COMPACTED INORGANIC Clays 25.1 CUBIC FT

8 2 1/2 CEMENT GROUT & 6" CONCRETE CAP " 4.4 CUBIC FT

7 CONTRACTOR'S OR LANDOWNER'S CERTIFICATION: This water well was (1) constructed, (2) reconstructed, or (3) plugged under my jurisdiction and was completed on (mo/day/year) 8-18-82 and this record is true to the best of my knowledge and belief. KansasWater Well Contractor's License No. This Water Well Record was completed on (mo/day/yr) 9-13-82Under the business name of TRI COMPANY CONSTRUCTION INC. by (signature) Curran

INSTRUCTIONS: Use typewriter or ball point pen, PLEASE PRESS FIRMLY and PRINT clearly. Please fill in blanks, underline or circle the correct answers. Send top three copies to Kansas Department of Health and Environment, Division of Environment, Environmental Geology Section, Topeka, KS 66620. Send one to WATER WELL OWNER and retain one for your records.