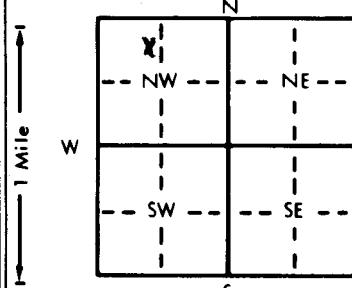


## WATER WELL RECORD Form WWC-5 KSA 82a-1212

1 LOCATION OF WATER WELL:	Fraction 1/4 N/W 1/4 N/W 1/4	Section Number 15	Township Number T 26 S	Range Number R 3 E
---------------------------	---------------------------------	----------------------	---------------------------	-----------------------

County: **BUTTLER** Distance and direction from nearest town or city street address of well if located within city?**470' E & 140' S. OF N/W CORNER OF SECTION 15**2 WATER WELL OWNER: **CITY OF BENTON, KANSAS**RR#, St. Address, Box #: **CITY HALL** Board of Agriculture, Division of Water Resources  
City, State, ZIP Code: **BENTON, KANSAS 67017** Application Number:

3 LOCATE WELL'S LOCATION WITH AN "X" IN SECTION BOX:

4 DEPTH OF COMPLETED WELL: **11** ft. ELEVATION: \_\_\_\_\_

Depth(s) Groundwater Encountered 1. ft. 2. ft. 3. ft.

WELL'S STATIC WATER LEVEL: **DRY** ft. below land surface measured on mo/day/yr **8-18-82**

Pump test data: Well water was ft. after hours pumping gpm

Est. Yield gpm: Well water was ft. after hours pumping gpm

Bore Hole Diameter in. to ft. and in. to ft.

WELL WATER TO BE USED AS: 5 Public water supply 8 Air conditioning 11 Injection well

1 Domestic 3 Feedlot 6 Oil field water supply 9 Dewatering

2 Irrigation 4 Industrial 7 Lawn and garden only 10 Observation well

Was a chemical/bacteriological sample submitted to Department? Yes.....No.....; If yes, mo/day/yr sample was submitted

Water Well Disinfected? Yes No

5 TYPE OF BLANK CASING USED: 5 Wrought iron 8 Concrete tile CASING JOINTS: Glued ..... Clamped .....

1 Steel 3 RMP (SR) 6 Asbestos-Cement 9 Other (specify below) Welded .....

2 PVC 4 ABS 7 Fiberglass **BRICK & STONE** Threaded .....

Blank casing diameter in. to ft., Dia in. to ft., Dia in. to ft. in. to ft.

Casing height above land surface **Removed to Elevation 1355** in. weight lbs./ft. Wall thickness or gauge No. ....

TYPE OF SCREEN OR PERFORATION MATERIAL: 7 PVC 10 Asbestos-cement

1 Steel 3 Stainless steel 5 Fiberglass 8 RMP (SR) 11 Other (specify) .....

2 Brass 4 Galvanized steel 6 Concrete tile 9 ABS 12 None used (open hole)

SCREEN OR PERFORATION OPENINGS ARE: 5 Gauzed wrapped 8 Saw cut 11 None (open hole)

1 Continuous slot 3 Mill slot 6 Wire wrapped 9 Drilled holes

2 Louvered shutter 4 Key punched 7 Torch cut 10 Other (specify) .....

SCREEN-PERFORATED INTERVALS: From ft. to ft., From ft. to ft. ft. to ft.

From ft. to ft., From ft. to ft. ft. to ft.

GRAVEL PACK INTERVALS: From ft. to ft., From ft. to ft. ft. to ft.

From ft. to ft., From ft. to ft. ft. to ft.

6 GROUT MATERIAL: 1 Neat cement 2 Cement grout 3 Bentonite 4 Other **INORGANIC CLAYS**

Grout Intervals: From ft. to ft., From ft. to ft., From ft. to ft., From ft. to ft.

What is the nearest source of possible contamination: 10 Livestock pens 14 Abandoned water well

1 Septic tank 4 Lateral lines 7 Pit privy 11 Fuel storage 15 Oil well/Gas well

2 Sewer lines 5 Cess pool 6 **Sewage lagoon** 12 Fertilizer storage 16 Other (specify below)

3 Watertight sewer lines 6 Seepage pit 9 Feedyard 13 Insecticide storage

How many feet? /

Direction from well? **SOUTH**

FROM TO LITHOLOGIC LOG FROM TO LITHOLOGIC LOG

**11 0 COMPACTED INORGANIC CLAYS (amount ft) 216 CUBIC FT.**7 CONTRACTOR'S OR LANDOWNER'S CERTIFICATION: This water well was (1) constructed, (2) reconstructed, or (3) plugged under my jurisdiction and was completed on (mo/day/year) **8-18-82** and this record is true to the best of my knowledge and belief. KansasWater Well Contractor's License No. This Water Well Record was completed on (mo/day/yr) **9-15-83**Under the business name of **Tri Company Contr. Inc.** by (signature) **John Schaefer**

INSTRUCTIONS: Use typewriter or ball point pen, PLEASE PRESS FIRMLY and PRINT clearly. Please fill in blanks, underline or circle the correct answers. Send top three copies to Kansas Department of Health and Environment, Division of Environment, Environmental Geology Section, Topeka, KS 66620. Send one to WATER WELL OWNER and retain one for your records.