

WATER WELL RECORD

Form WWC-5

KSA 82a-1212

1 LOCATION OF WATER WELL:

Fraction

SW $\frac{1}{4}$ NE $\frac{1}{4}$ SE $\frac{1}{4}$

Section Number

16

Township Number

T

26

S

Range Number

R 3

EW

Distance and direction from nearest town or city street address of well if located within city?

1/2 mile east of Benton

2 WATER WELL OWNER: City of Benton


RR#, St. Address, Box # : Box 388

Board of Agriculture, Division of Water Resources

City, State, ZIP Code : Benton, KS 67017

Application Number:

3 LOCATE WELL'S LOCATION WITH AN "X" IN SECTION BOX:

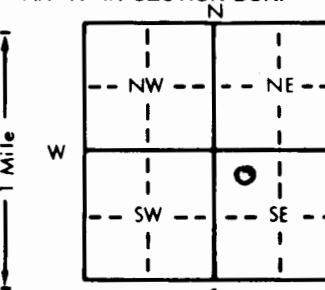

4 DEPTH OF COMPLETED WELL... 60' ft. ELEVATION: 1364'

Depth(s) Groundwater Encountered 1. 45' ft. 2. ft. 3. ft.

WELL'S STATIC WATER LEVEL 18 ft. below land surface measured on mo/day/yr 5/10/94

Pump test data: Well water was ft. after hours pumping gpm

Est. Yield gpm: Well water was ft. after hours pumping gpm

Bore Hole Diameter in. to ft., and in. to ft.

WELL WATER USED AS: 5 Public water supply 8 Air conditioning 11 Injection well

1 Domestic WAS 3 Feedlot 6 Oil field water supply 9 Dewatering 12 Other (Specify below)

2 Irrigation 4 Industrial 7 Lawn and garden only 10 Monitoring well

Was a chemical/bacteriological sample submitted to Department? Yes No If yes, mo/day/yr sample was submittedWater Well Disinfected? Yes No

5 TYPE OF BLANK CASING USED:

1 Steel 3 RMP (SR)
2 PVC 4 ABS

5 Wrought iron

8 Concrete tile

CASING JOINTS: Glued Clamped

6 Asbestos-Cement

9 Other (specify below)

Welded

7 Fiberglass

Threaded

Blank casing diameter 12 in. to 60 ft. Dia in. to ft. Dia in. to ft.

Casing height above land surface in. weight lbs./ft. Wall thickness or gauge No.

TYPE OF SCREEN OR PERFORATION MATERIAL:

1 Steel 3 Stainless steel
2 Brass 4 Galvanized steel

7 PVC

10 Asbestos-cement

8 RMP (SR)

11 Other (specify)

9 ABS

12 None used (open hole)

SCREEN OR PERFORATION OPENINGS ARE:

1 Continuous slot 3 Mill slot
2 Louvered shutter 4 Key punched

5 Gauzed wrapped

8 Saw cut

11 None (open hole)

6 Wire wrapped

9 Drilled holes

7 Torch cut

10 Other (specify)

SCREEN-PERFORATED INTERVALS: From NA ft. to NA ft., From ft. to ft., From ft. to ft.

From ft. to ft., From ft. to ft., From ft. to ft.

GRAVEL PACK INTERVALS: From ft. to ft., From ft. to ft., From ft. to ft.

From ft. to ft., From ft. to ft., From ft. to ft.

6 GROUT MATERIAL: 1 Neat cement 2 Cement grout 3 Bentonite 4 Other

Grout Intervals: From 6 ft. to 3 ft., From ft. to ft., From ft. to ft.

What is the nearest source of possible contamination: 10 Livestock pens 14 Abandoned water well

1 Septic tank 4 Lateral lines 7 Pit privy 11 Fuel storage 15 Oil well/Gas well
2 Sewer lines 5 Cess pool 8 Sewage lagoon 12 Fertilizer storage 16 Other (specify below)
3 Watertight sewer lines 6 Seepage pit 9 Feedyard 13 Insecticide storage

Direction from well? SW How many feet 150

FROM TO LITHOLOGIC LOG FROM TO PLUGGING INTERVALS

60 18 Sand, 32.95 cu ft

18 6 Clay, 9.41 cu ft

6 3 Cement grout, 2.35 cu ft

7 CONTRACTOR'S OR LANDOWNER'S CERTIFICATION: This water well was (1) constructed, (2) reconstructed, or (3) plugged under my jurisdiction and was completed on (mo/day/year) 5/10/94 and this record is true to the best of my knowledge and belief. Kansas

Water Well Contractor's License No. N/A This Water Well Record was completed on (mo/day/yr) 5/10/94

under the business name of City of Benton by (signature) *Bennie S. Bell Mayor*