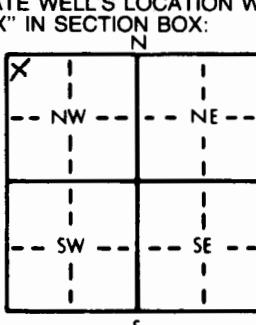


1 LOCATION OF WATER WELL:		Fraction County: BUTLER	1/4 NW 1/4 NW 1/4	Section Number 17	Township Number T 26 S	Range Number R 3 (E/W)
Distance and direction from nearest town or city street address of well if located within city? Z54 ANDOVER ROAD						
2 WATER WELL OWNER: JOHNSON'S SKELLY SERVICE RR#, St. Address, Box #: Z54 ANDOVER ROAD ROUTE 1 City, State, ZIP Code: LENONTON - KS - 67017 BOX 100						
3 LOCATE WELL'S LOCATION WITH AN "X" IN SECTION BOX: 						
4 DEPTH OF COMPLETED WELL 25 ft. ELEVATION: _____ Depth(s) Groundwater Encountered 20 ft. 2. - ft. 3. - ft. WELL'S STATIC WATER LEVEL 16.3 ft. below land surface measured on mo/day/yr 01-24-94 Pump test data: Well water was _____ ft. after _____ hours pumping _____ gpm Est. Yield _____ gpm: Well water was _____ ft. after _____ hours pumping _____ gpm Bore Hole Diameter 7.5 in. to 25 ft., and _____ in. to _____ ft. WELL WATER TO BE USED AS: 5 Public water supply 8 Air conditioning 11 Injection well 1 Domestic 3 Feedlot 6 Oil field water supply 9 Dewatering 12 Other (Specify below) 2 Irrigation 4 Industrial 7 Lawn and garden only 10 Monitoring well Was a chemical/bacteriological sample submitted to Department? Yes _____ No X ; If yes, mo/day/yr sample was submitted Water Well Disinfected? Yes — No X						
5 TYPE OF BLANK CASING USED: 1 Steel 3 RMP (SR) 5 Wrought iron 8 Concrete tile CASING JOINTS: Glued — Clamped — 2 PVC 4 ABS 6 Asbestos-Cement 9 Other (specify below) Welded — Blank casing diameter 2 in. to 15 ft., Dia — in. to — ft., Dia — in. to — ft. Casing height above land surface 24 in., weight SCH 40 lbs./ft. Wall thickness or gauge No. —						
6 TYPE OF SCREEN OR PERFORATION MATERIAL: 1 Steel 3 Stainless steel 5 Fiberglass 7 PVC 10 Asbestos-cement 2 Brass 4 Galvanized steel 6 Concrete tile 8 RMP (SR) 11 Other (specify) — SCREEN OR PERFORATION OPENINGS ARE: 1 Continuous slot 3 Mill slot 6 Wire wrapped 9 Drilled holes 2 Louvered shutter 4 Key punched 7 Torch cut 10 Other (specify) — SCREEN-PERFORATED INTERVALS: From 15 ft. to 25 ft., From — ft. to — ft. From — ft. to — ft., From — ft. to — ft. From — ft. to — ft., From — ft. to — ft. From — ft. to — ft., From — ft. to — ft. GRAVEL PACK INTERVALS: From 13 ft. to 25 ft., From — ft. to — ft. From — ft. to — ft., From — ft. to — ft. From — ft. to — ft., From — ft. to — ft. 6 GROUT MATERIAL: 1 Neat cement 2 Cement grout 3 Bentonite 4 Other — Grout Intervals: From GL ft. to 11 ft., From 3 ft. to 17 ft., From — ft. to 13 ft., From — ft. to — ft. What is the nearest source of possible contamination: 1 Septic tank 4 Lateral lines 7 Pit privy 10 Livestock pens 14 Abandoned water well 2 Sewer lines 5 Cess pool 8 Sewage lagoon 11 Fuel storage 15 Oil well/Gas well 3 Watertight sewer lines 6 Seepage pit 9 Feedyard 12 Fertilizer storage 16 Other (specify below) CONTAMINATED SITE						
7 DIRECTION FROM WELL? FROM TO LITHOLOGIC LOG FROM TO PLUGGING INTERVALS GL 2 SOIL - CLAY LOAM 2 16 SILTY CLAY 16 20 CLAY 20 25 SILTY CLAY TS 25						
7 CONTRACTOR'S OR LANDOWNER'S CERTIFICATION: This water well was (1) constructed, (2) reconstructed, or (3) plugged under my jurisdiction and was completed on (mo/day/year) 01-21-94 and this record is true to the best of my knowledge and belief. Kansas Water Well Contractor's License No. 479 This Water Well Record was completed on (mo/day/yr) 02-20-94 under the business name of EBB ERTS DRILLING by (signature) Gregory E. Ebberts						