

1 LOCATION OF WATER WELL:

Fraction SW 1/4 SW 1/4 NW 1/4Section Number 18Township Number T 26 SRange Number R 30 EWCounty: BentonDistance and direction from nearest town or city street address of well if located within city?
15 West 3/4 South of Benton

2 WATER WELL OWNER:

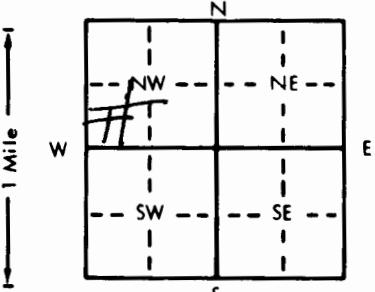
Roberta Williams 67017RR#, St. Address, Box # Box 10B Benton Kans

Board of Agriculture, Division of Water Resources

City, State, ZIP Code

Application Number:

3 LOCATE WELL'S LOCATION WITH AN "X" IN SECTION BOX:

4 DEPTH OF COMPLETED WELL 90 ft. ELEVATION: _____Depth(s) Groundwater Encountered 1. 75 ft. 2. _____ ft. 3. _____ ft.WELL'S STATIC WATER LEVEL 35 ft. below land surface measured on mo/day/yr

Pump test data: Well water was _____ ft. after _____ hours pumping _____ gpm

Est. Yield 30 gpm: Well water was _____ ft. after _____ hours pumping _____ gpmBore Hole Diameter 8 1/2 in. to _____ ft., and _____ in. to _____ ft.

WELL WATER TO BE USED AS: 5 Public water supply 8 Air conditioning 11 Injection well

1 Domestic 3 Feedlot 6 Oil field water supply 9 Dewatering 12 Other (Specify below)

2 Irrigation 4 Industrial 7 Lawn and garden only 10 Observation well

Was a chemical/bacteriological sample submitted to Department? Yes No If yes, mo/day/yr sample was submittedWater Well Disinfected? Yes No

5 TYPE OF BLANK CASING USED:

1 Steel 3 RMP (SR)
2 PVC 4 ABS

5 Wrought iron

8 Concrete tile

CASING JOINTS: Glued Clamped

6 Asbestos-Cement

9 Other (specify below)

Welded

7 Fiberglass

.....

Threaded Blank casing diameter 5 in. to 60 ft., Dia in. to ft., Dia in. to ft.Casing height above land surface 18 in., weight 200 lbs./ft. Wall thickness or gauge No. 1214

TYPE OF SCREEN OR PERFORATION MATERIAL:

1 Steel 3 Stainless steel
2 Brass 4 Galvanized steel

5 Fiberglass

7 PVC

10 Asbestos-cement

6 Concrete tile

8 RMP (SR)

11 Other (specify)

5 Gauzed wrapped

9 ABS

12 None used (open hole)

6 Wire wrapped

.....

8 Saw cut

7 Torch cut

.....

9 Drilled holes

.....

.....

10 Other (specify)

SCREEN OR PERFORATION OPENINGS ARE: 5 Gauzed wrapped 8 Saw cut 11 None (open hole)

1 Continuous slot 3 Mill slot
2 Louvered shutter 4 Key punched

.....

.....

.....

60 ft. to 90 ft., From ft. to ft., From ft. to ft.From ft. to ft., From ft. to ft., From ft. to ft.SCREEN-PERFORATED INTERVALS: From ft. to ft., From ft. to ft., From ft. to ft.GRAVEL PACK INTERVALS: From ft. to ft., From ft. to ft., From ft. to ft.From ft. to ft., From ft. to ft., From ft. to ft.

6 GROUT MATERIAL: 1 Neat cement 2 Cement grout 3 Bentonite 4 Other

Grout Intervals: From ft. to 13 ft., From ft. to ft., From ft. to ft.

What is the nearest source of possible contamination: 10 Livestock pens 14 Abandoned water well

1 Septic tank 4 Lateral lines 7 Pit privy 11 Fuel storage 15 Oil well/Gas well

2 Sewer lines 5 Cess pool 8 Sewage lagoon 12 Fertilizer storage 16 Other (specify below)

3 Watertight sewer lines 6 Seepage pit 9 Feedyard 13 Insecticide storage

Direction from well? W How many feet? 10

FROM TO LITHOLOGIC LOG FROM TO LITHOLOGIC LOG

0 6 Soil6 18 Shay18 60 Shale60 90 Lime & Shale1 CONTRACTOR'S OR LANDOWNER'S CERTIFICATION: This water well was 1 constructed, 2 reconstructed, or 3 plugged under my jurisdiction and was completed on (mo/day/year) 4-27-84 and this record is true to the best of my knowledge and belief. KansasWater Well Contractor's License No. 257 This Water Well Record was completed on (mo/day/year) 6/20/84 by (signature) Charles WinterUnder the business name of Winter Well Drill

INSTRUCTIONS: Use typewriter or ball point pen, PLEASE PRESS FIRMLY and PRINT clearly. Please fill in blanks, underline or circle the correct answers. Send top three copies to Kansas Department of Health and Environment, Division of Environment, Environmental Geology Section, Topeka, KS 66620. Send one to WATER WELL OWNER and retain one for your records.