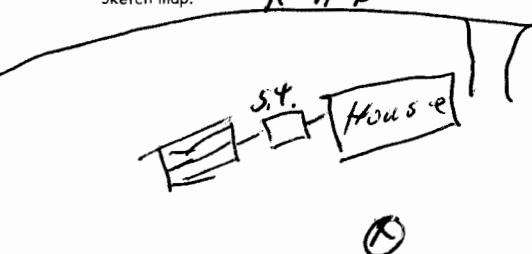
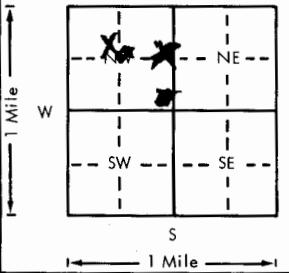


1. Location of well:	County Butcher	Fraction SE 1/4 NW 1/4 NW 1/4	Section number 21	Township number T 26 S	Range number R 3 E/W	
2. Distance and direction from nearest town or city:	3/4 mi. S. of Benton		3. Owner of well: Keith Joy			
Street address of well location if in city:			R.R. or street: Pr.			
4. Locate with "X" in section below:	Sketch map: R 27 D 		6. Bore hole dia. 8 in. Completion date 9-25-78			
			Well depth 46 ft.			
5. Type and color of material			From 0	To 3		
Topsoil			0	3		
Red Clay			3	10		
Limestone (White)			10	38		
Shale (Gray)			38	46		
(Use a second sheet if needed)						
18. Elevation:	19. Remarks: owner will install a 4x4x4 concrete slab					20. Water well contractor's certification: This well was drilled under my jurisdiction and this report is true to the best of my knowledge and belief. Prev. + Const Co 353
Topography:	Hill Slope Upland Valley					Business name Box 944 License No. 1/4
						Address 1/4 Date 9-25-78
						Signed Keith Joy Authorized representative 1/4