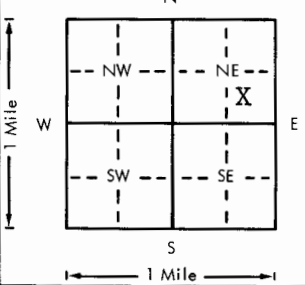


USE TYPEWRITER OR BALL
POINT PEN-PRESS FIRMLY,
PRINT CLEARLY.

WATER WELL RECORD
KSA 82a-1201-1215

Kansas Department of Health and
Environment-Division of Environment
(Water well Contractors)
Topeka, Kansas 66620

1. Location of well:		County BUTLER	Fraction S 1/4 SE 1/4 NE 1/4	Section number 25	Township number T 26 S	Range number R 3E E/W
2. Distance and direction from nearest town or city: #3 Briar Cliff Dr.		3. Owner of well: Lynn Copeland Homes Inc.				
Street address of well location if in city: Briar Cliff Estates		R.R. or street: 6827 E. Harry				
		City, state, zip code: Wichita, Kansas				
4. Locate with "X" in section below:		Sketch map:				
						
5. Type and color of material		From	To	6. Bore hole dia. 11 in. Completion date 5-16-78		
Topsoil		0	3	Well depth 80 ft.		
Brown Clay		3	6	7. Cable tool <input checked="" type="checkbox"/> Rotary <input type="checkbox"/> Driven <input type="checkbox"/> Dig <input type="checkbox"/> Hollow rod <input type="checkbox"/> Jetted <input type="checkbox"/> Bored <input type="checkbox"/> Reverse rotary		
Light Tan Shale		6	26	8. Use: <input type="checkbox"/> Domestic <input type="checkbox"/> Public supply <input type="checkbox"/> Industry <input type="checkbox"/> Irrigation <input type="checkbox"/> Air conditioning <input type="checkbox"/> Stock <input checked="" type="checkbox"/> Lawn <input type="checkbox"/> Oil field water <input type="checkbox"/> Other		
Light Blue Shale		26	51	9. Casing: Material styrene Height: Above or 46 ft. Threaded <input type="checkbox"/> Welded <input checked="" type="checkbox"/> Surface 12 in. RMP <input checked="" type="checkbox"/> PVC <input type="checkbox"/> Weight 81 lbs./ft. Dia. 5 in. to 80 ft. depth Wall Thickness: inches or Dia. 5 in. to 80 ft. depth gage No. 200		
Light Tan Shale		51	80	10. Screen: Manufacturer's name Sunflower Plastic Type styrene Dia. 5" Slot/size .06 Length 50' Set between 30 ft. and 80 ft. Gravel pack? yes Size range of material 1/4-1/8"		
				11. Static water level: 60 ft. below land surface Date 5-16-78		
				12. Pumping level below land surfaces: ____ ft. after ____ hrs. pumping ____ g.p.m. ____ ft. after ____ hrs. pumping ____ g.p.m. Estimated maximum yield ____ g.p.m.		
				13. Water sample submitted: ____ mo./day/yr. ____ Yes ____ No Date ____		
				14. Well head completion: capped ____ Pitless adapter 12 Inches above grade		
				15. Well grouted? yes 1-2 Fine Sand Mix With: ____ Neat cement ____ Bentonite <input checked="" type="checkbox"/> Concrete Depth: From 40" ft. to 14 ft.		
				16. Nearest source of possible contamination: ft. ____ Direction ____ Type NONE Well disinfected upon completion? <input checked="" type="checkbox"/> Yes ____ No		
				17. Pump: <input checked="" type="checkbox"/> Not installed Manufacturer's name ____ Model number ____ HP ____ Volts ____ Length of drop pipe ____ ft. capacity ____ g.p.m. Type: ____ Submersible ____ Turbine ____ Jet ____ Reciprocating ____ Centrifugal ____ Other		
				(Use a second sheet if needed)		
18. Elevation:	19. Remarks:		20. Water well contractor's certification:			
Topography: ____ Hill <input checked="" type="checkbox"/> Slope ____ Upland ____ Valley	No apparent source for contamination.		This well was drilled under my jurisdiction and this report is true to the best of my knowledge and belief. Harp Well & Pump 236 Business name License No. Address Wichita, Kansas 67209 Signed M. Arnold Date 5-14-78 Authorized representative			