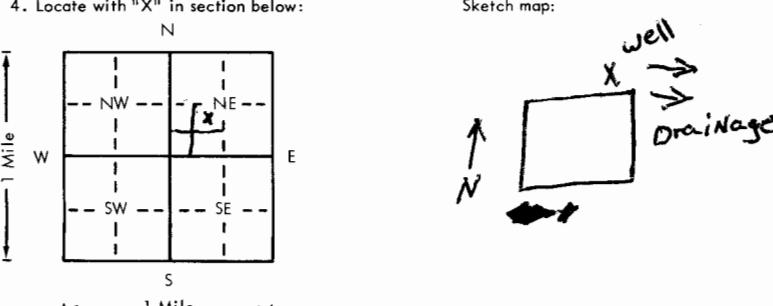


1. Location of well:	County Butler	Fraction NE 1/4 SW 1/4 NE 1/4	Section number 25	Township number T 26	Range number S R 3
2. Distance and direction from nearest town or city: OF BENTON	3. Owner of well: Larry EVANS				
Street address of well location if in city: Lot 26 Block B Lakeview circle	R.R. or street: 9400 E LINCOLN APT 513		City, state, zip code: WICHITA KS 67207		
4. Locate with "X" in section below:	Sketch map:		6. Bore hole dia. 8-5 in. Completion date 5-31-78 Well depth 54 ft.		
			7. <input checked="" type="checkbox"/> Cable tool <input type="checkbox"/> Rotary <input type="checkbox"/> Driven <input type="checkbox"/> Dug <input type="checkbox"/> Hollow rod <input type="checkbox"/> Jetted <input type="checkbox"/> Bored <input type="checkbox"/> Reverse rotary		
5. Type and color of material	From	To	8. Use: <input checked="" type="checkbox"/> Domestic <input type="checkbox"/> Public supply <input type="checkbox"/> Industry <input type="checkbox"/> Irrigation <input type="checkbox"/> Air conditioning <input type="checkbox"/> Stock <input type="checkbox"/> Lawn <input type="checkbox"/> Oil field water <input type="checkbox"/> Other		
Fill dirt	0	1	9. Casing: Material PITS Height: Above or below Threaded <input type="checkbox"/> Welded 91 Surface 16 in. RMP <input checked="" type="checkbox"/> PVC Weight 16 lbs./ft. Dia. 5 in. to 54 ft. depth Wall Thickness: inches or Dia. 5 in. to 54 ft. depth Gage No. .200		
Top soil	1	2	10. Screen: Manufacturer's name SUNflower PITS PIPE Type RMP Dia. 5" Slot/gauze 1/16 Length 10 ft Set between 44 ft. and 54 ft. ft. and 54 ft. Gravel pack? yes Size range of material 25-34		
Clay yellow Brown	2	4	11. Static water level: 22 ft. below land surface Date 5-31-78		
clay Red	4	8	12. Pumping level below land surfaces: NA ft. after hrs. pumping g.p.m. ft. after hrs. pumping g.p.m.		
clay yellow gray	8	15	Estimated maximum yield g.p.m.		
clay Lavender	15	18	13. Water sample submitted: mo./day/yr. Yes <input checked="" type="checkbox"/> No Date		
clay yellow gray	18	25	14. Well head completion: NA Pitless adapter 16 Inches above grade		
clay Green	25	31	15. Well grouted? yes With: Neat cement <input type="checkbox"/> Bentonite <input checked="" type="checkbox"/> Concrete Depth: From 13 ft. to 3 ft.		
Lime Gray	31	40	16. Nearest source of possible contamination: ft. Direction Type Well disinfected upon completion? Yes <input type="checkbox"/> No		
Lime Yellow (water)	40	54	17. Pump: <input checked="" type="checkbox"/> Not installed Manufacturer's name Model number HP Volts Length of drop pipe ft. capacity g.p.m. Type: <input type="checkbox"/> Submersible <input type="checkbox"/> Turbine <input type="checkbox"/> Jet <input type="checkbox"/> Reciprocating <input type="checkbox"/> Centrifugal <input type="checkbox"/> Other		
(Use a second sheet if needed)			18. Elevation: Topography: <input type="checkbox"/> Hill <input checked="" type="checkbox"/> Slope <input type="checkbox"/> Upland <input type="checkbox"/> Valley		
19. Remarks: OWNER WILL INSTALL CONCRETE SLAB			20. Water well contractor's certification: This well was drilled under my jurisdiction and this report is true to the best of my knowledge and belief. Braddy water wells 363 Business name Braddy water wells 363 License No. Address R# 82 Box 217A Douglass KS Signed Richard Braddy Date 6-1-78 Authorized representative		