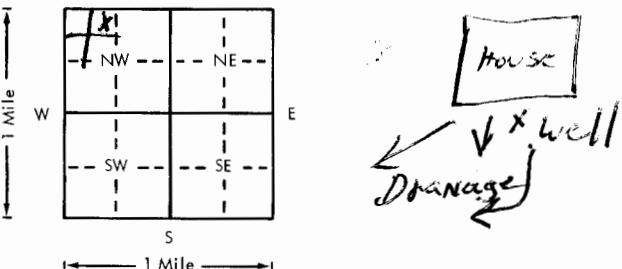


USE TYPEWRITER OR BALL
POINT PEN-PRESS FIRMLY,
PRINT CLEARLY.

WATER WELL RECORD
KSA 82a-1201-1215

Kansas Department of Health and
Environment-Division of Environment
(Water well Contractors)
Topeka, Kansas 66620

1. Location of well:		County Butler	Fraction NE 1/4 NW 1/4 NW 1/4	Section number 25	Township number T 26 S R 3	Range number 3
2. Distance and direction from nearest town or city: Benton MO 3E of		3. Owner of well: Herb Bruce		R.R. or street: 7701 E Kellogg		
Street address of well location if in city: Wichita KS 16405 E. 45th. N.		City, state, zip code: Wichita KS 67207				
4. Locate with "X" in section below:		Sketch map:		6. Bore hole dia. 8.5 in. Completion date 8-24-78 Well depth 97 ft.		
				7. <input checked="" type="checkbox"/> Cable tool <input type="checkbox"/> Rotary <input type="checkbox"/> Driven <input type="checkbox"/> Dug <input type="checkbox"/> Hollow rod <input type="checkbox"/> Jetted <input type="checkbox"/> Bored <input type="checkbox"/> Reverse rotary		
5. Type and color of material		From		To		8. Use: <input checked="" type="checkbox"/> Domestic <input type="checkbox"/> Public supply <input type="checkbox"/> Industry <input type="checkbox"/> Irrigation <input type="checkbox"/> Air conditioning <input type="checkbox"/> Stock <input type="checkbox"/> Lawn <input type="checkbox"/> Oil field water <input type="checkbox"/> Other
Fill Dirt		0		1		9. Casing: Material PBS Height: Above or below Threaded <input type="checkbox"/> Welded <input checked="" type="checkbox"/> Surface 24 in. RMP <input checked="" type="checkbox"/> PVC <input type="checkbox"/> Weight <input type="checkbox"/> lbs./ft. Dia. 5 in. to 97 ft. depth Wall Thickness: inches or Dia. <input type="checkbox"/> in. to <input type="checkbox"/> ft. depth gage No. 200
Top Soil		1		2		10. Screen: Manufacturer's name SUNFLOWER PITS P. PE INC Type RMP Dia. 5" Slot/gauze 4/16 Length 10' Set between 87 ft. and 97 ft. ft. and <input type="checkbox"/> ft. Gravel pack? <input checked="" type="checkbox"/> Size range of material 1/4-3/4
Brown Clay		2		10		11. Static water level: <input type="checkbox"/> mo./day/yr. 66 ft. below land surface Date 8/24/78
Lime Stone yellow		10		28		12. Pumping level below land surfaces: NA <input type="checkbox"/> ft. after <input type="checkbox"/> hrs. pumping <input type="checkbox"/> g.p.m. <input type="checkbox"/> ft. after <input type="checkbox"/> hrs. pumping <input type="checkbox"/> g.p.m. Estimated maximum yield <input type="checkbox"/> g.p.m.
Limestone yellow with clay		28		35		13. Water sample submitted: <input type="checkbox"/> mo./day/yr. <input type="checkbox"/> Yes <input checked="" type="checkbox"/> No Date <input type="checkbox"/>
Shale gray		35		44		14. Well head completion: <input checked="" type="checkbox"/> Pitless adapter 24 Inches above grade
Clay green		44		49		15. Well grouted? yes With: <input type="checkbox"/> Neat cement <input type="checkbox"/> Bentonite <input checked="" type="checkbox"/> Concrete Depth: From 13 ft. to 3 ft.
clay lavender		49		52		16. Nearest source of possible contamination: NA ft. <input type="checkbox"/> Direction <input type="checkbox"/> Type <input type="checkbox"/> Well disinfected upon completion? <input checked="" type="checkbox"/> Yes <input type="checkbox"/> No
clay light gray green		52		59		17. Pump: <input type="checkbox"/> Not installed Manufacturer's name <input type="checkbox"/> Model number <input type="checkbox"/> HP <input type="checkbox"/> Volts <input type="checkbox"/> Length of drop pipe <input type="checkbox"/> ft. capacity <input type="checkbox"/> g.p.m. Type: <input type="checkbox"/> Submersible <input type="checkbox"/> Turbine <input type="checkbox"/> Jet <input type="checkbox"/> Reciprocating <input type="checkbox"/> Centrifugal <input type="checkbox"/> Other
Limestone yellow with clay		59		65		20. Water well contractor's certification: This well was drilled under my jurisdiction and this report is true to the best of my knowledge and belief. Braddy Water Wells 363 Business name <input type="checkbox"/> License No. <input type="checkbox"/> Address R 2 B 0 X 21 W Douglas KS Signed Richard Braddy Date 8-27-78 Authorized representative
Shale gray green		65		83		
Limestone yellow (water)		83		95		
Shale Blue gray		95		97		
(Use a second sheet if needed)						
18. Elevation:		19. Remarks:		20. Water well contractor's certification:		
Topography: <input type="checkbox"/> Hill <input checked="" type="checkbox"/> Slope <input type="checkbox"/> Upland <input type="checkbox"/> Valley		Owner will install concrete slab				