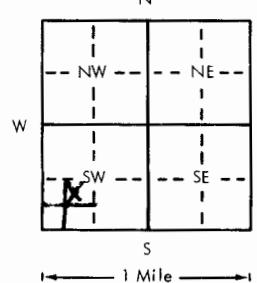
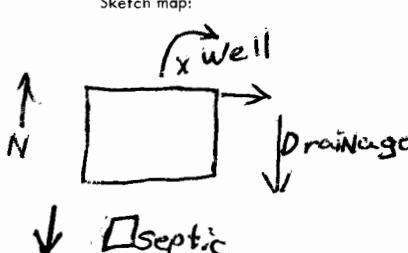


1. Location of well:	County Butler	Fraction NE 1/4 SW 1/4 SW 1/4	Section number 25	Township number T 26	Range number S R 3
2. Distance and direction from nearest town or city:	2 1/2 E 1 3/4 S OF BENTON		3. Owner of well: Herb Bruce		
Street address of well location if in city: #3 Whitecliff Ct. Lot 46 Block B			R.R. or street: 7701 E Kellogg		
4. Locate with "X" in section below:			Sketch map: 	6. Bore hole dia. 8.5 in. Completion date 5-25-78 Well depth 85 ft.	
			7. <input checked="" type="checkbox"/> Cable tool <input type="checkbox"/> Rotary <input type="checkbox"/> Driven <input type="checkbox"/> Dug <input type="checkbox"/> Hollow rod <input type="checkbox"/> Jetted <input type="checkbox"/> Bored <input type="checkbox"/> Reverse rotary		
			8. Use: <input checked="" type="checkbox"/> Domestic <input type="checkbox"/> Public supply <input type="checkbox"/> Industry <input type="checkbox"/> Irrigation <input type="checkbox"/> Air conditioning <input type="checkbox"/> Stock <input type="checkbox"/> Lawn <input type="checkbox"/> Oil field water <input type="checkbox"/> Other		
			9. Casing: Material PITS Height: Above or below Threaded <input type="checkbox"/> Welded 91 Surface 16 in. RMP <input checked="" type="checkbox"/> PVC Weight 100 lbs./ft. Dia. 5 in. to 85 ft. depth Wall Thickness: inches or Dia. 5 in. to 85 ft. depth Gauge No. .200		
5. Type and color of material			10. Screen: Manufacturer's name SUNFLOWER PITS PIPE Type RMP Dia. 5" Slot/gauze 1/16 Length 10 FT Set between 75 ft. and 85 ft. ft. and 85 ft. Gravel pack? yes Size range of material 18-30		
Fill Dirt			11. Static water level: 45 ft. below land surface Date 5-25-78		
Top Soil			12. Pumping level below land surfaces: NA		
Clay Red			ft. after 0 hrs. pumping 0 g.p.m.		
Lime yellow			ft. after 0 hrs. pumping 0 g.p.m.		
Clay yellow			Estimated maximum yield 0 g.p.m.		
Shale blue gray			13. Water sample submitted: no Yes <input checked="" type="checkbox"/> No Date 5-25-78		
Shale greenish yellow			14. Well head completion: 16 inches above grade Pitless, adapter		
Clay Lavender			15. Well grouted? yes		
Clay green with cobbles			With: <input type="checkbox"/> Neat cement <input checked="" type="checkbox"/> Bentonite <input type="checkbox"/> Concrete Depth: From 13 ft. to 3 ft.		
Shale blue gray			16. Nearest source of possible contamination: ft. 100 Direction So. Type Septic		
Lime yellow gray			Well disinfected upon completion? no Yes <input type="checkbox"/> No		
Lime yellow (water)			17. Pump: X Not installed Manufacturer's name Braddy water wells Model number 363 HP 1/2 Volts 115 Length of drop pipe 0 ft. capacity 0 g.p.m.		
(Use a second sheet if needed)			Type: <input type="checkbox"/> Submersible <input type="checkbox"/> Turbine <input type="checkbox"/> Jet <input type="checkbox"/> Reciprocating <input type="checkbox"/> Centrifugal <input type="checkbox"/> Other		
18. Elevation:	19. Remarks: owner will install concrete slab		20. Water well contractor's certification: This well was drilled under my jurisdiction and this report is true to the best of my knowledge and belief. Braddy water wells 363 Business name Reg Douglass KS. License No. Address Richard Braddy Date 5-25-78 Signed Richard Braddy Authorized representative		
Topography: <input type="checkbox"/> Hill <input checked="" type="checkbox"/> Slope <input type="checkbox"/> Upland <input type="checkbox"/> Valley					