

1 LOCATION OF WATER WELL:

Fraction

SW $\frac{1}{4}$ NW $\frac{1}{4}$ SE $\frac{1}{4}$ NE $\frac{1}{4}$

Section Number

Township Number

Range Number

County: Butler

T 26 S

R 30 E/W

Distance and direction from nearest town or city street address of well if located within city?
5 West 6 North of Augusta

2 WATER WELL OWNER: Bob Molinger

87208

Board of Agriculture, Division of Water Resources

RR#, St. Address, Box #:


6313 E 10th

Wichita Kan

Application Number:

3 LOCATE WELL'S LOCATION WITH

AN "X" IN SECTION BOX:

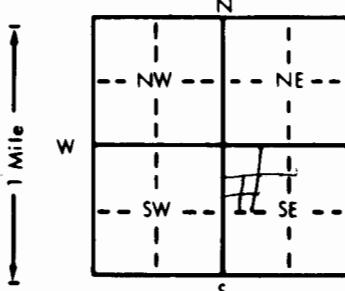

4 DEPTH OF COMPLETED WELL.....85 ft. ELEVATION:

Depth(s) Groundwater Encountered 1. 85 ft. 2. ft. 3. ft.

WELL'S STATIC WATER LEVEL 20 ft. below land surface measured on mo/day/yr

Pump test data: Well water was ft. after hours pumping gpm

Est. Yield 20 gpm Well water was ft. after hours pumping gpm

Bore Hole Diameter 85 in. to ft. and in. to ft.

WELL WATER TO BE USED AS: 5 Public water supply 8 Air conditioning 11 Injection well

1 Domestic 3 Feedlot 6 Oil field water supply 9 Dewatering 12 Other (Specify below)

2 Irrigation 4 Industrial 7 Lawn and garden only 10 Observation well

Was a chemical/bacteriological sample submitted to Department? Yes No If yes, mo/day/yr sample was submitted

Water Well Disinfected? Yes X No

5 TYPE OF BLANK CASING USED:

1 Steel (3) RMP (SR)
2 PVC 4 ABS

5 Wrought iron

8 Concrete tile

CASING JOINTS: Glued X Clamped

6 Asbestos-Cement

9 Other (specify below)

Welded

7 Fiberglass

Threaded

Blank casing diameter 5 in. to 50 ft., Dia

in. to ft., Dia in. to in. to ft.

Casing height above land surface 18 in., weight

200 lbs./ft. Wall thickness or gauge No. 1214

TYPE OF SCREEN OR PERFORATION MATERIAL:

1 Steel 3 Stainless steel
2 Brass 4 Galvanized steel

5 Fiberglass

7 PVC

10 Asbestos-cement

6 Concrete tile

8 RMP (SR)

11 Other (specify)

7 Gauzed wrapped

9 ABS

12 None used (open hole)

8 Wire wrapped

10 Other (specify)

13 Saw cut

11 None (open hole)

9 Torch cut

14 Drilled holes

10 Key punched

15 Other (specify)

SCREEN-PERFORATED INTERVALS: From 50 ft. to 85 ft., From

ft. to ft., From ft. to ft., From ft. to ft.

GRAVEL PACK INTERVALS: From 40 ft. to 85 ft., From

ft. to ft., From ft. to ft., From ft. to ft.

From 20 ft. to 85 ft., From

ft. to ft., From ft. to ft., From ft. to ft.

6 GROUT MATERIAL:

1 Neat cement 2 Cement grout

3 Bentonite 4 Other

Grout Intervals: From 0 ft. to 14 ft., From ft. to ft., From ft. to ft., From ft. to ft.

What is the nearest source of possible contamination:

1 Septic tank 4 Lateral lines
2 Sewer lines 5 Cess pool
3 Watertight sewer lines 6 Seepage pit7 Pit privy
8 Sewage lagoon
9 Feedyard

10 Livestock pens

14 Abandoned water well

11 Fuel storage

15 Oil well/Gas well

12 Fertilizer storage

16 Other (specify below)

13 Insecticide storage

Direction from well?

How many feet?

100

FROM TO LITHOLOGIC LOG FROM TO LITHOLOGIC LOG

8 2 Soil
15 25 Clay
28 85 Shale
Limestone

7 CONTRACTOR'S OR LANDOWNER'S CERTIFICATION: This water well was (1) constructed, (2) reconstructed, or (3) plugged under my jurisdiction and was completed on (mo/day/year) 4/29/89 and this record is true to the best of my knowledge and belief. Kansas

Water Well Contractor's License No. 251 This Water Well Record was completed on (mo/day/year) 5/29/89 under the business name of Winter Well Drill by (signature) Charles Winter

INSTRUCTIONS: Use typewriter or ball point pen. PLEASE PRESS FIRMLY and PRINT clearly. Please fill in blanks, underline or circle the correct answers. Send top three copies to Kansas Department of Health and Environment, Bureau of Water Protection, Topeka, Kansas 66620-7320, Telephone: 913-862-9360. Send one to WATER WELL OWNER and retain one for your records.